


#22058-D

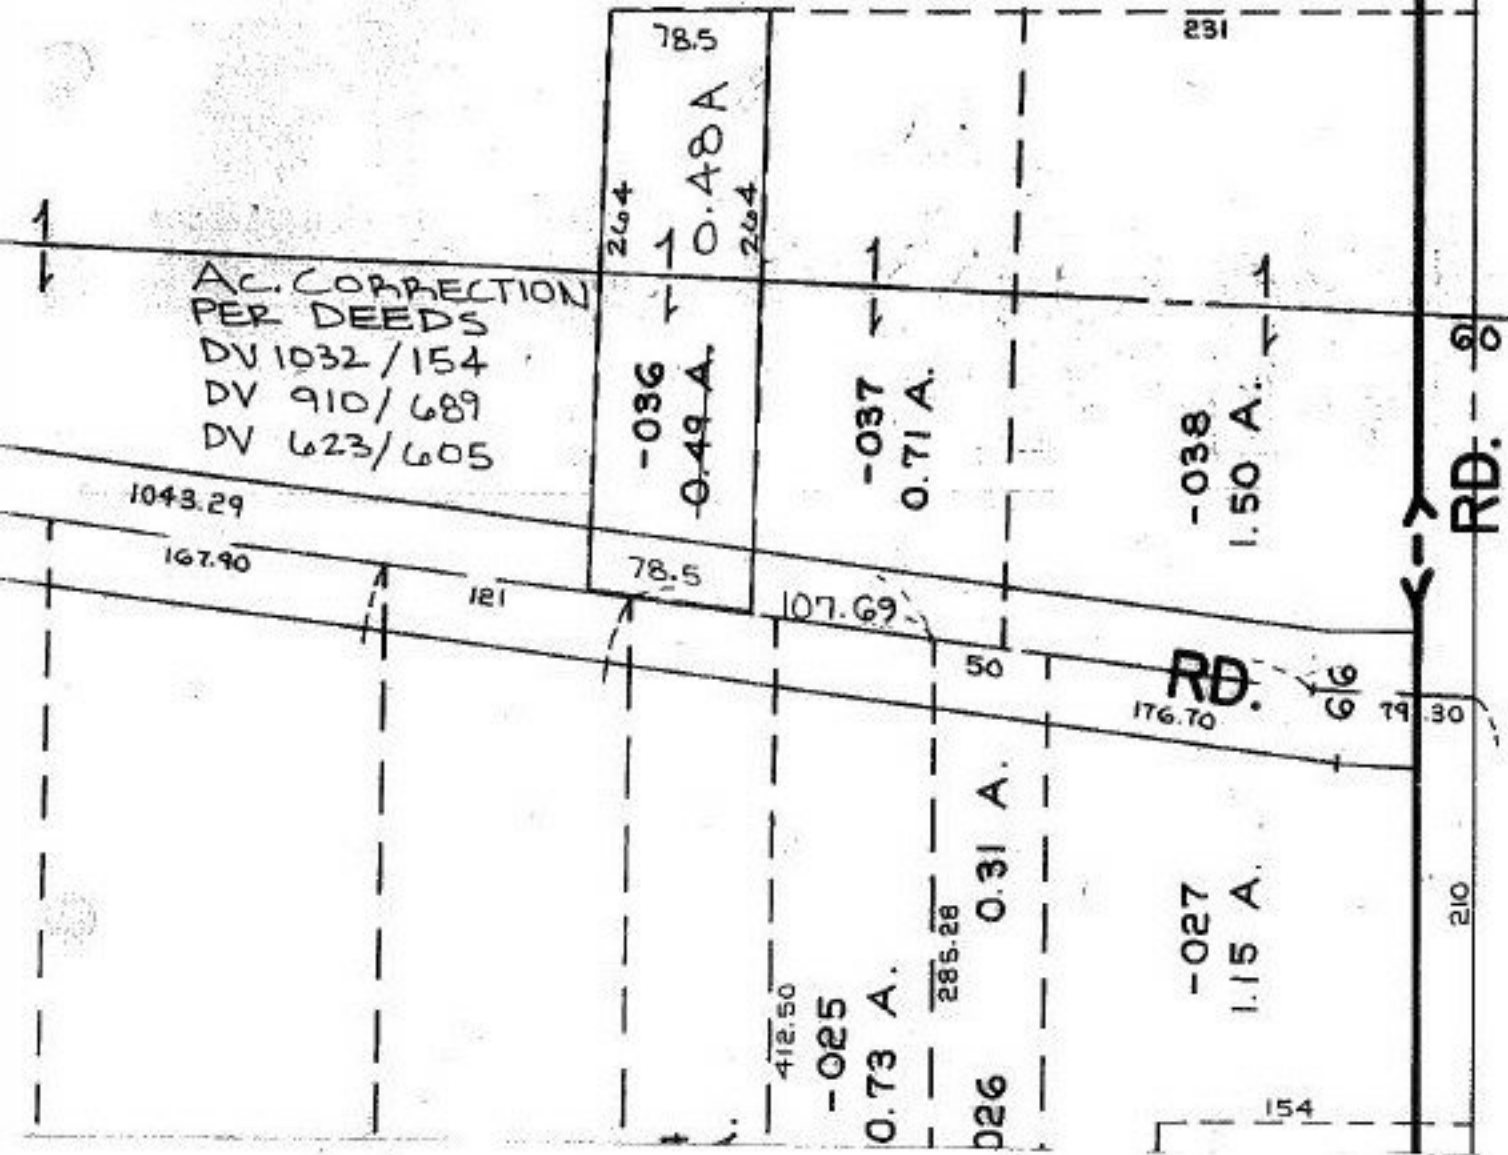

22058-D

APPROVED	
LORAIN CO.	
MAP DEPT.	
DATE 1-29-97	
PAGE 01-00-04316	
BY R. BELL	
VOID AFTER #	22058-D

UPDATE LORAIN COUNTY