


#22059

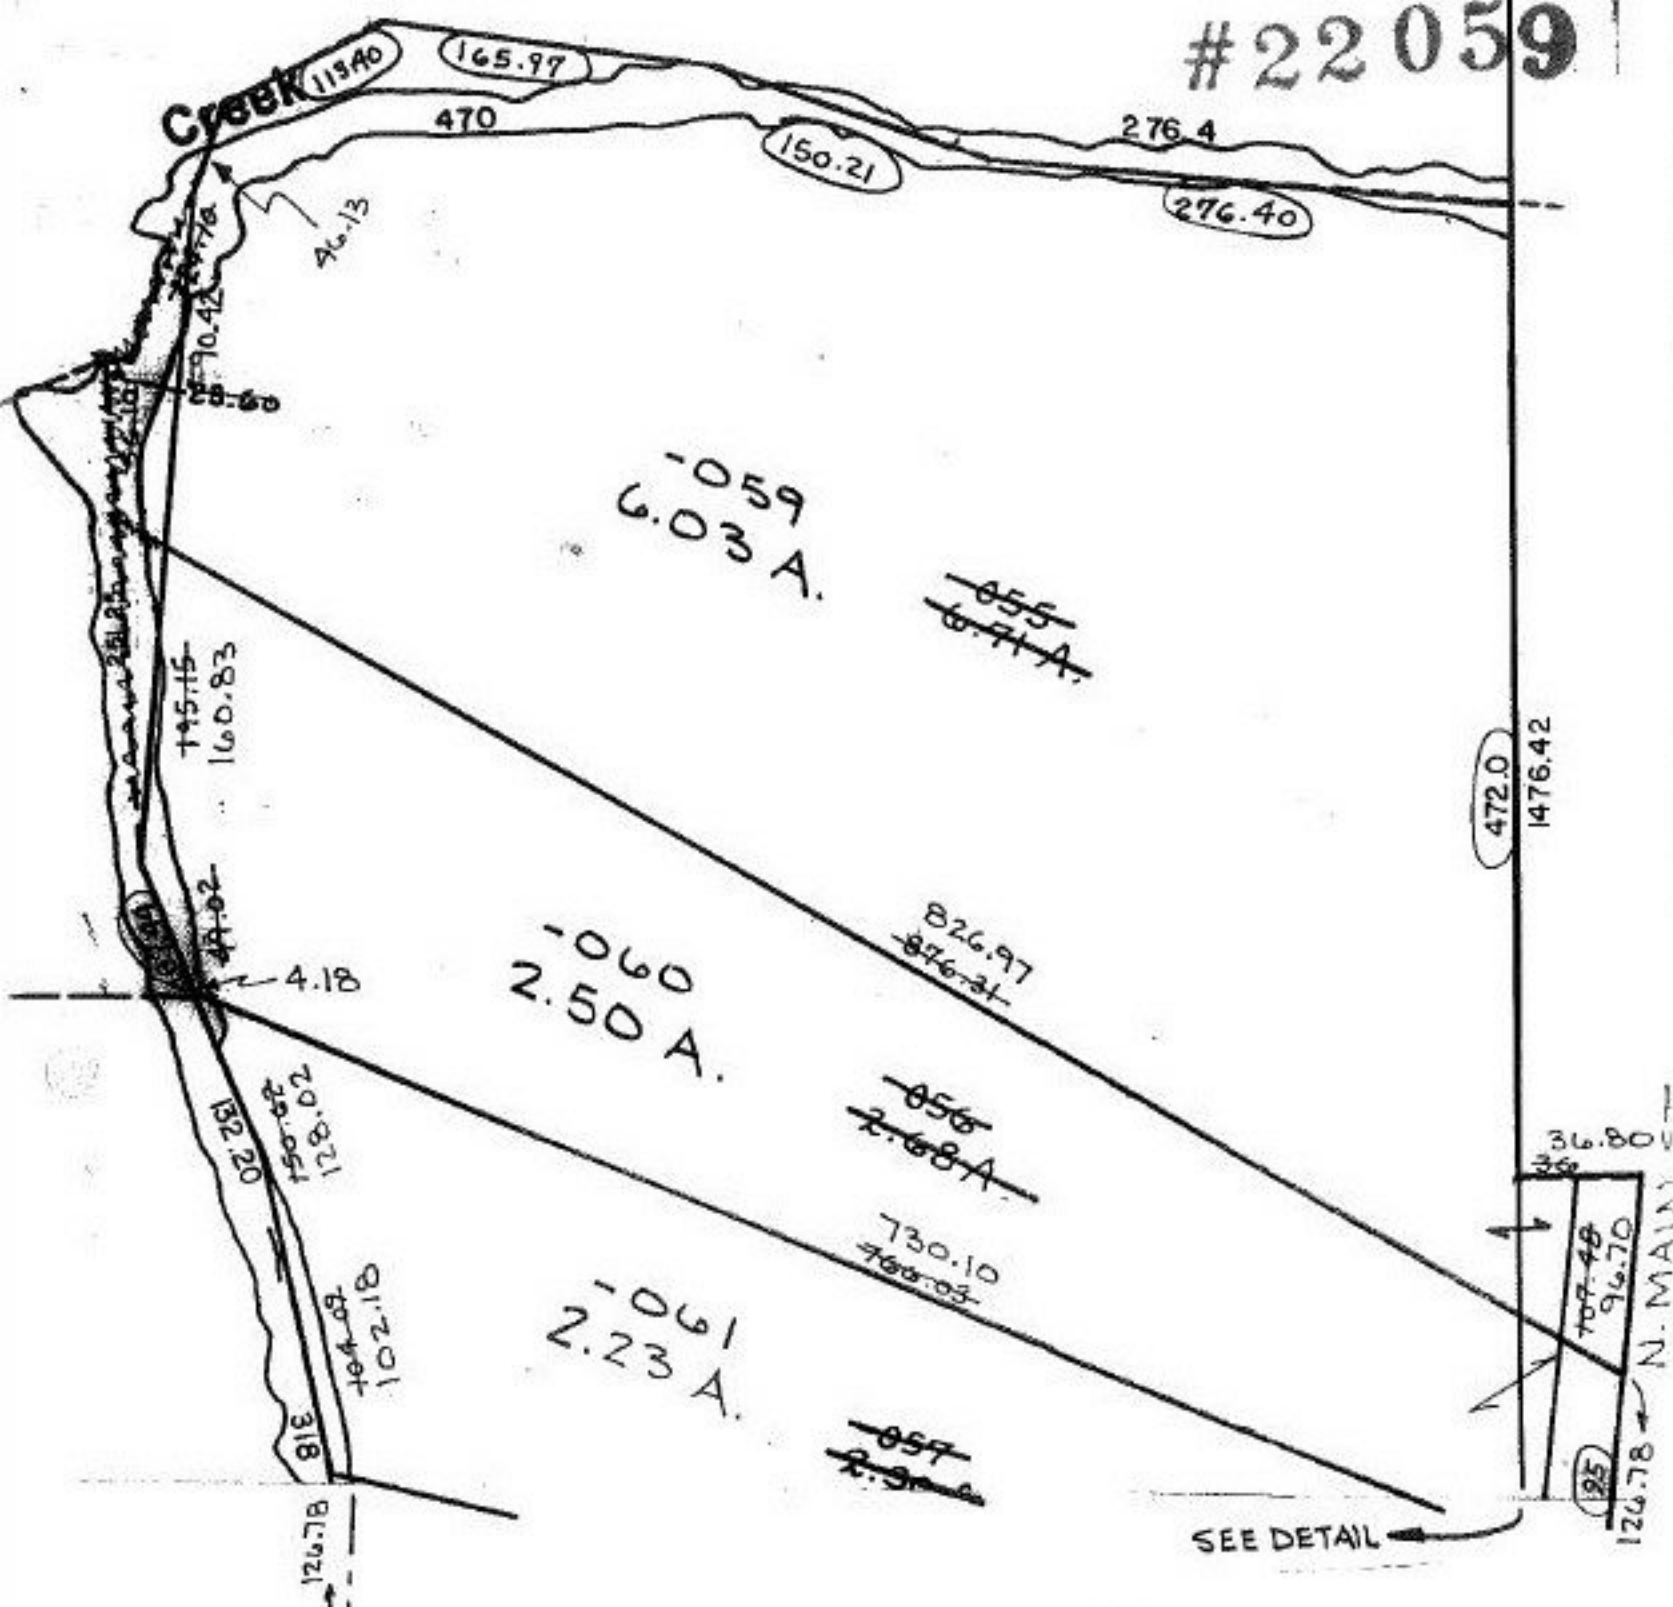

DETAIL
NO SCALE

22059

APPROVED
LORAIN CO.
MAP DEPT.
DATE 1-17-97
PAGE 5-00-019B
BY R. BELL
NO. # 22059

SUNRISE DR.