


#22060-D

COMBINATION

SEE II-00-013

COOLEY

837

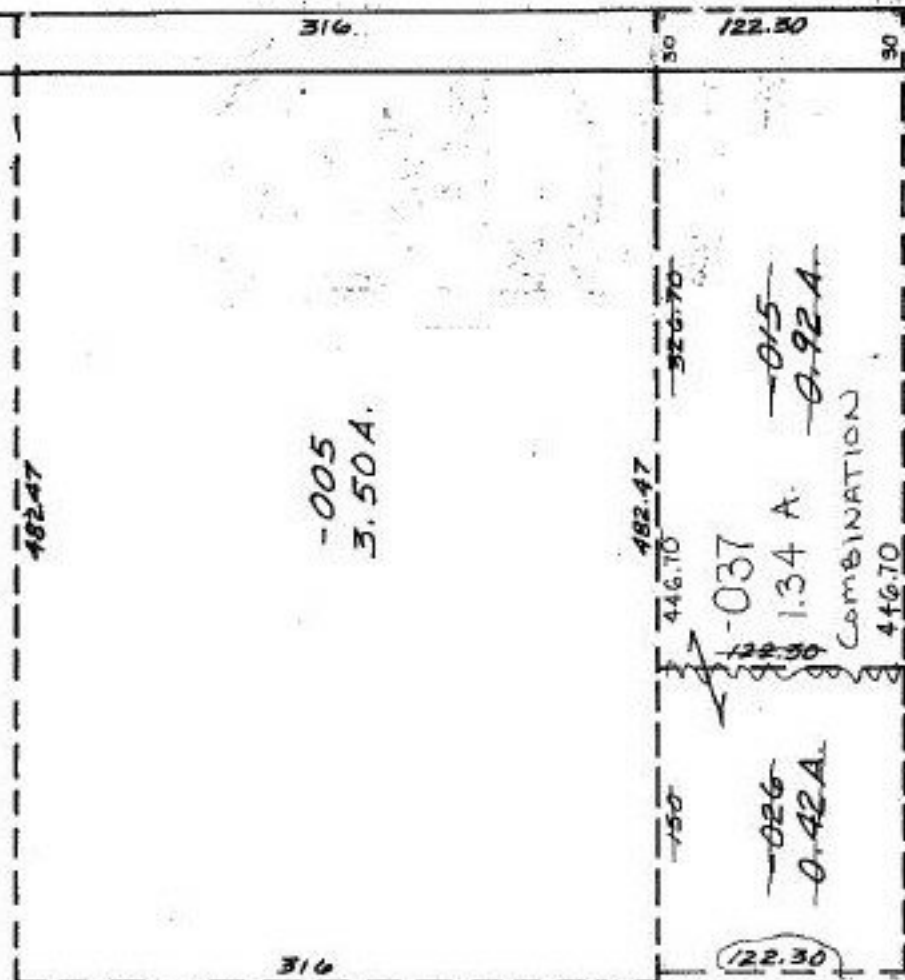

COMBINATION PER
 DESCRIPTION OF RECORD
 IN OR 1427-71
 PRIOR REFERENCES:
 OR 912-815
 DV 1352-682 PCL#2

#22060-D

APPROVED LORAIN CO. MAP DEPT
DATE 2/4/97
PAGE II-00-014-B
BY K.DYE/P. Bell

Pt. -031

Pt. 63.91 A.