


#22063

SEE II-00-100-B

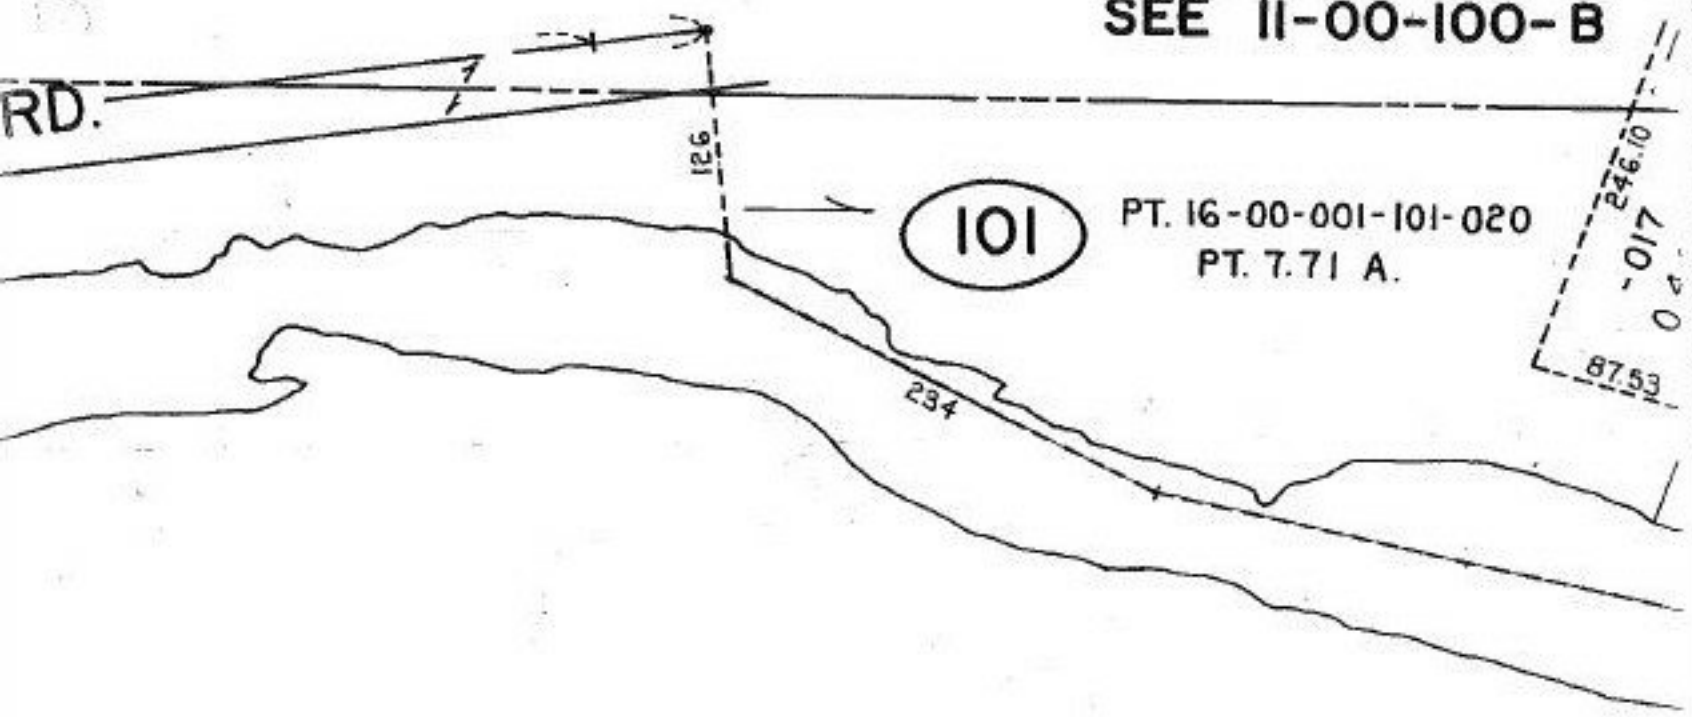

PT. 16-00-001-101-020
PT. 7.71 A.

101

#21130-D
~~PT. 019~~
~~PT. 67.14 A.~~
 Pt. -022
 Pt. 64.44 A.

#22063

APPROVED LORAIN CO. MAP DEPT
DATE 2/5/97
PAGE 16-00-001-B
BY K.DYE
#22063

A. 1097.74
PT. 7.5 CH. 1097.23

-002
9.18 A.