


BURSLEY

RD. 22063-D

231.20
-022
187.42
231.80

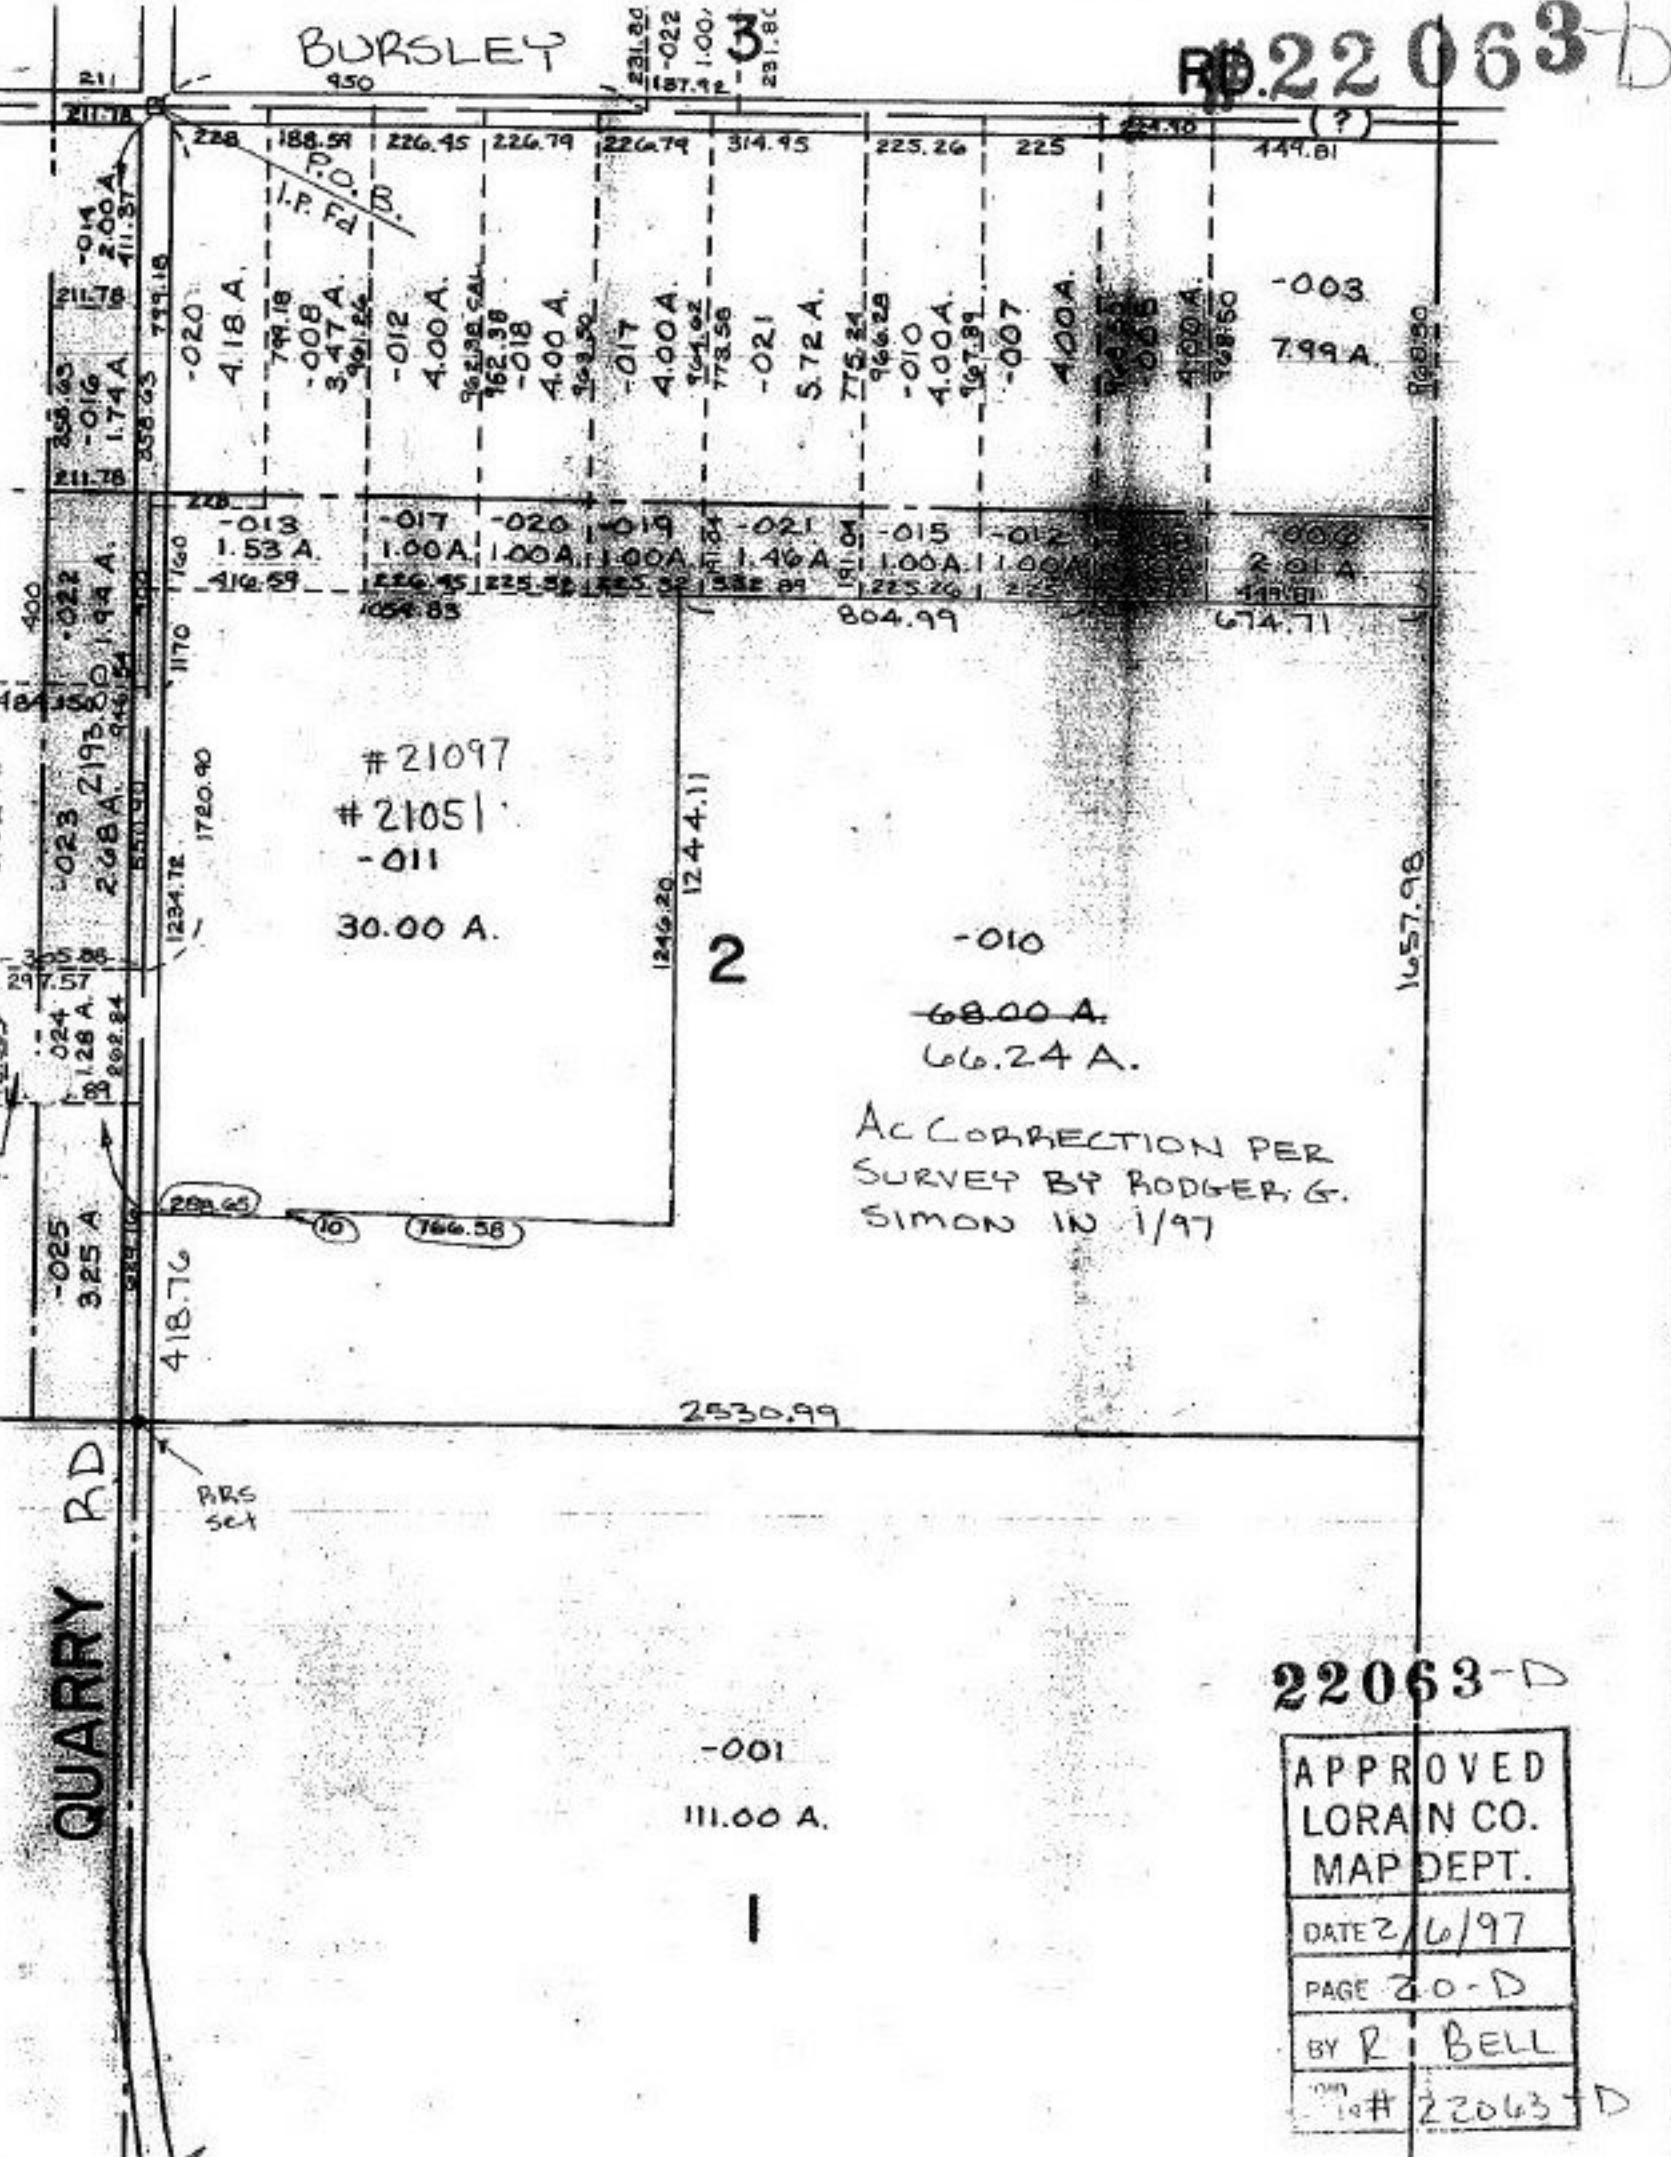

#21097
#21051
-011
30.00 A.

-010
~~68.00 A.~~
66.24 A.

AC CORRECTION PER
SURVEY BY RODGER G.
SIMON IN 1/97

-001
111.00 A.

22063-D

APPROVED
LORAIN CO.
MAP DEPT.
DATE 2/6/97
PAGE 20-D
BY R. BELL
10# 22063-D