


#22063  
SEE 11-00

PARSONS RD. &  
W. LINE OF GRAFTON TWP.

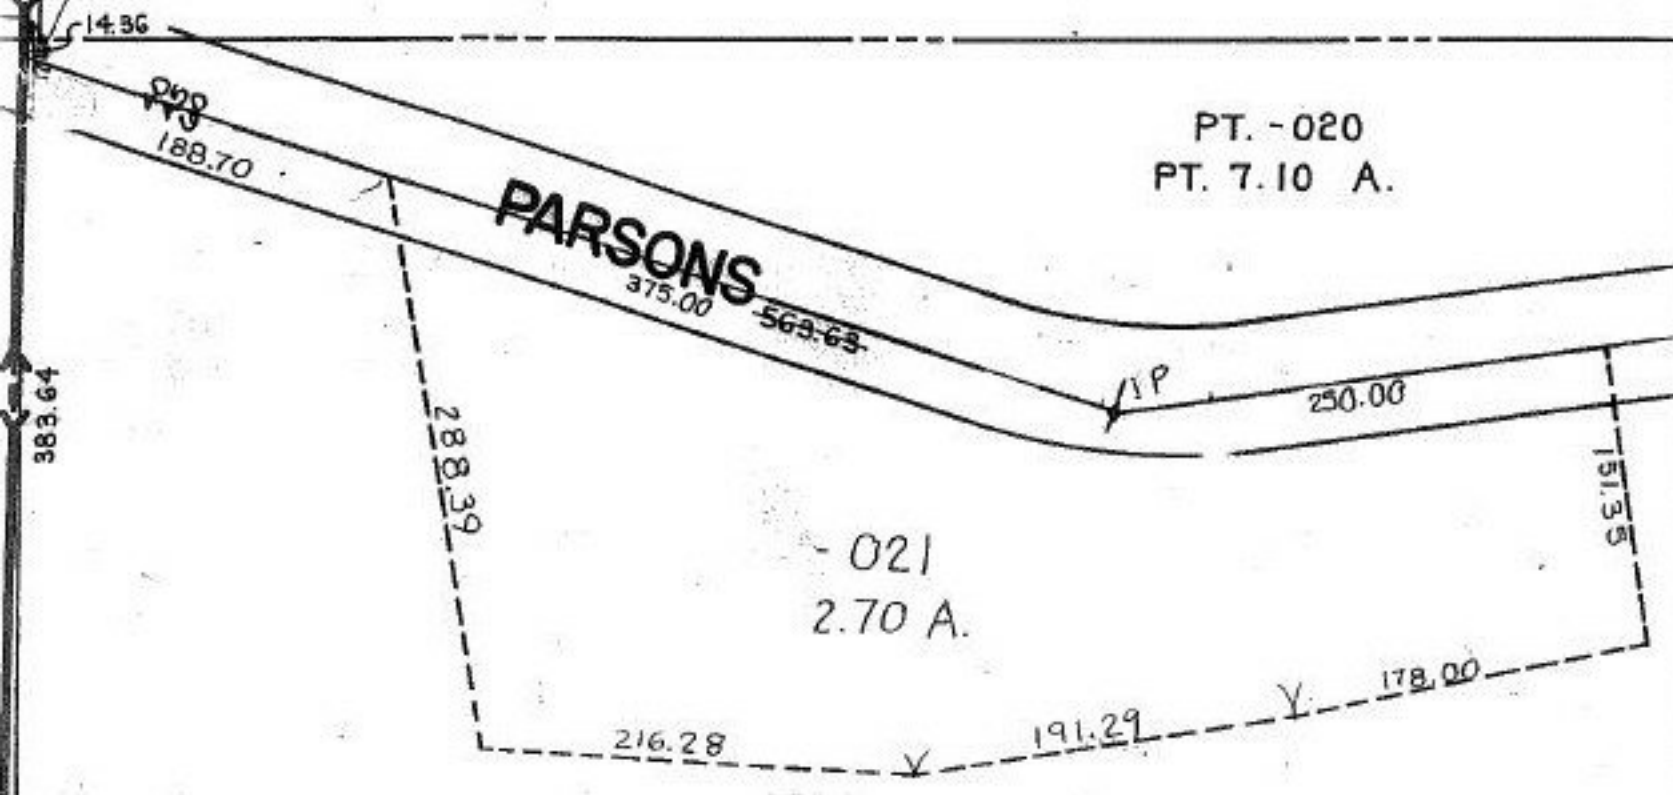

PRIOR INSTRUMENT OR 877/177  
 CLOSURE 0.11 PER 10,000  
 SURVEYED BY RODGER G. SIMON

1  
 (101)

#22063  
 APPROVED  
 LORAIN CO.  
 MAP DEPT  
 DATE 2/5/97  
 PAGE 1600-001-A  
 BY K. DYE  
 #22063

#21130-D  
~~PT. -019~~  
~~PT. 67.14 A.~~  
 Pt. -022  
 Pt. 64.44 A.