


#22067

WALKER ROAD

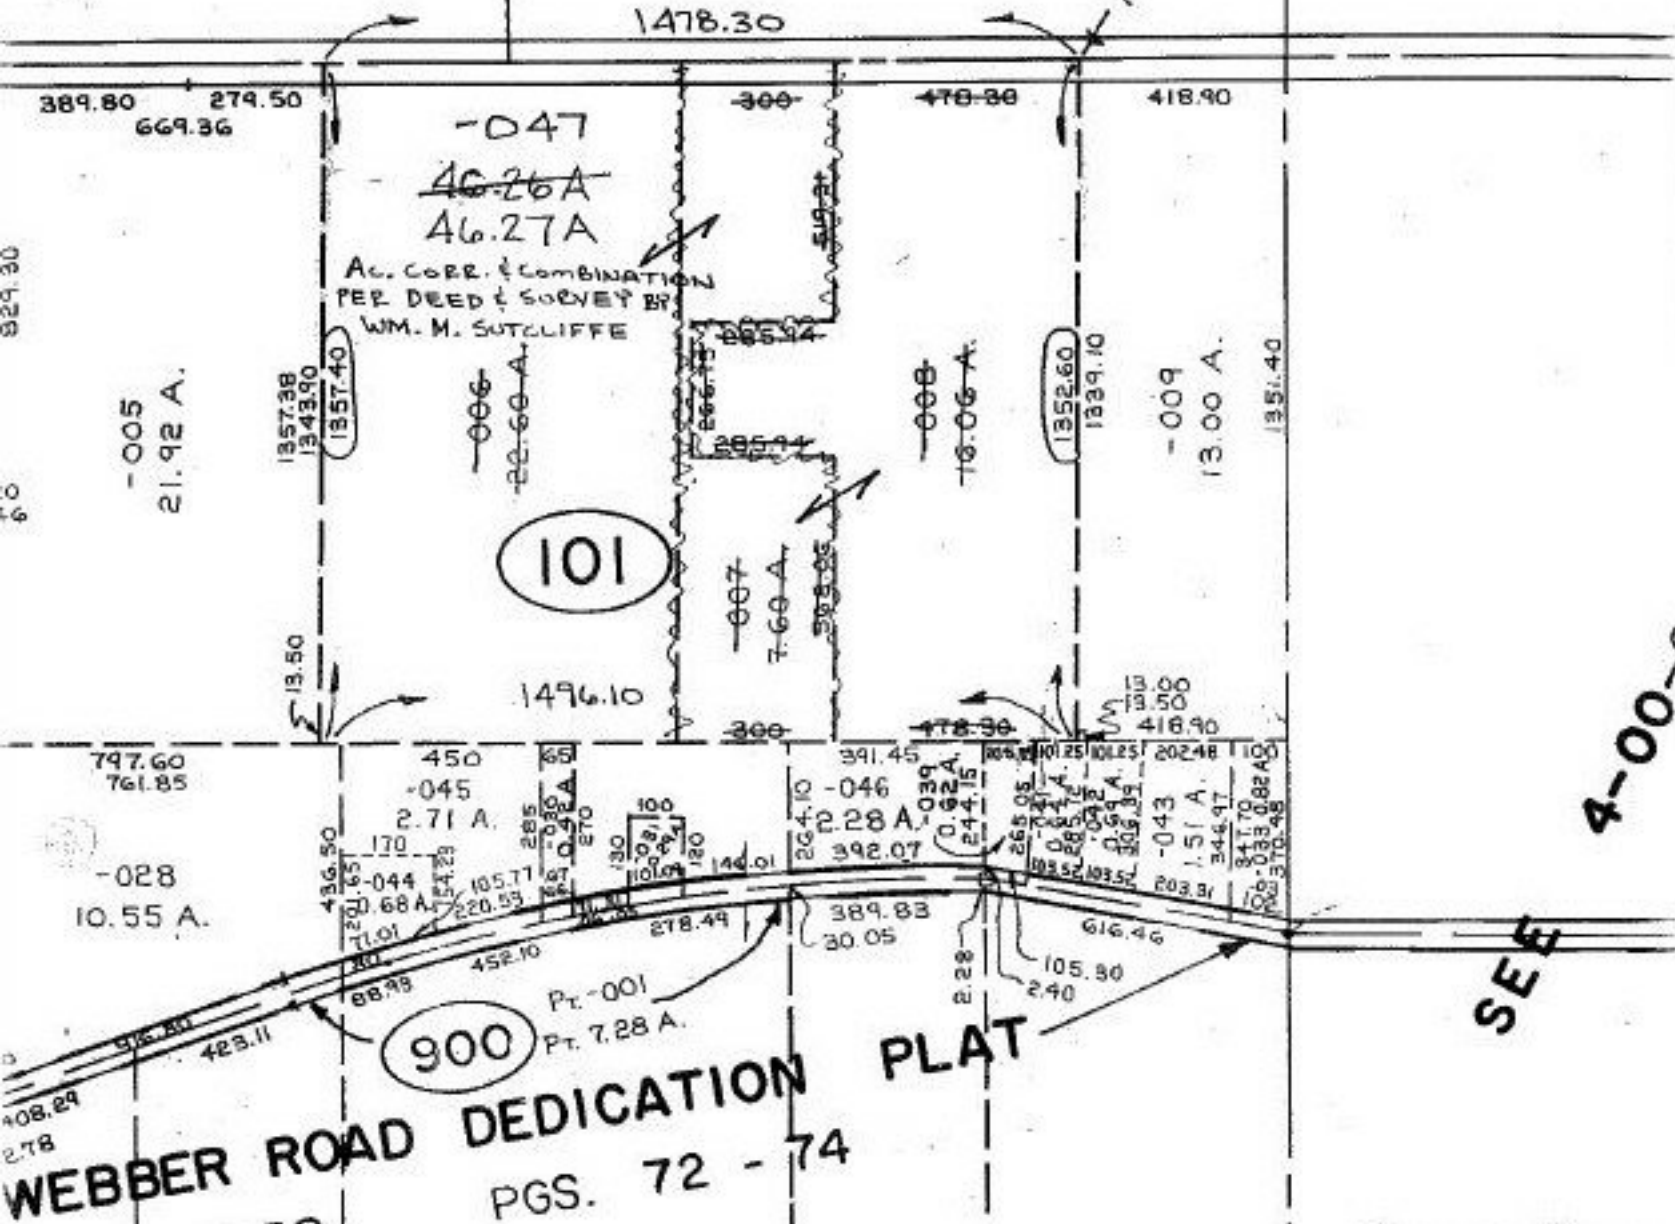

ACRE. CORR. & COMB.

#22067

APPROVED LORAIN CO. MAP DEPT.	
DATE 2-20-97	
PAGE 4-B	
BY R. BELL	
VOID AFTER #	22067