


WAKEMAN-LAGRANGE #22071 RICHIE

303
 R=5729.58
 R=5725.58
 16.44

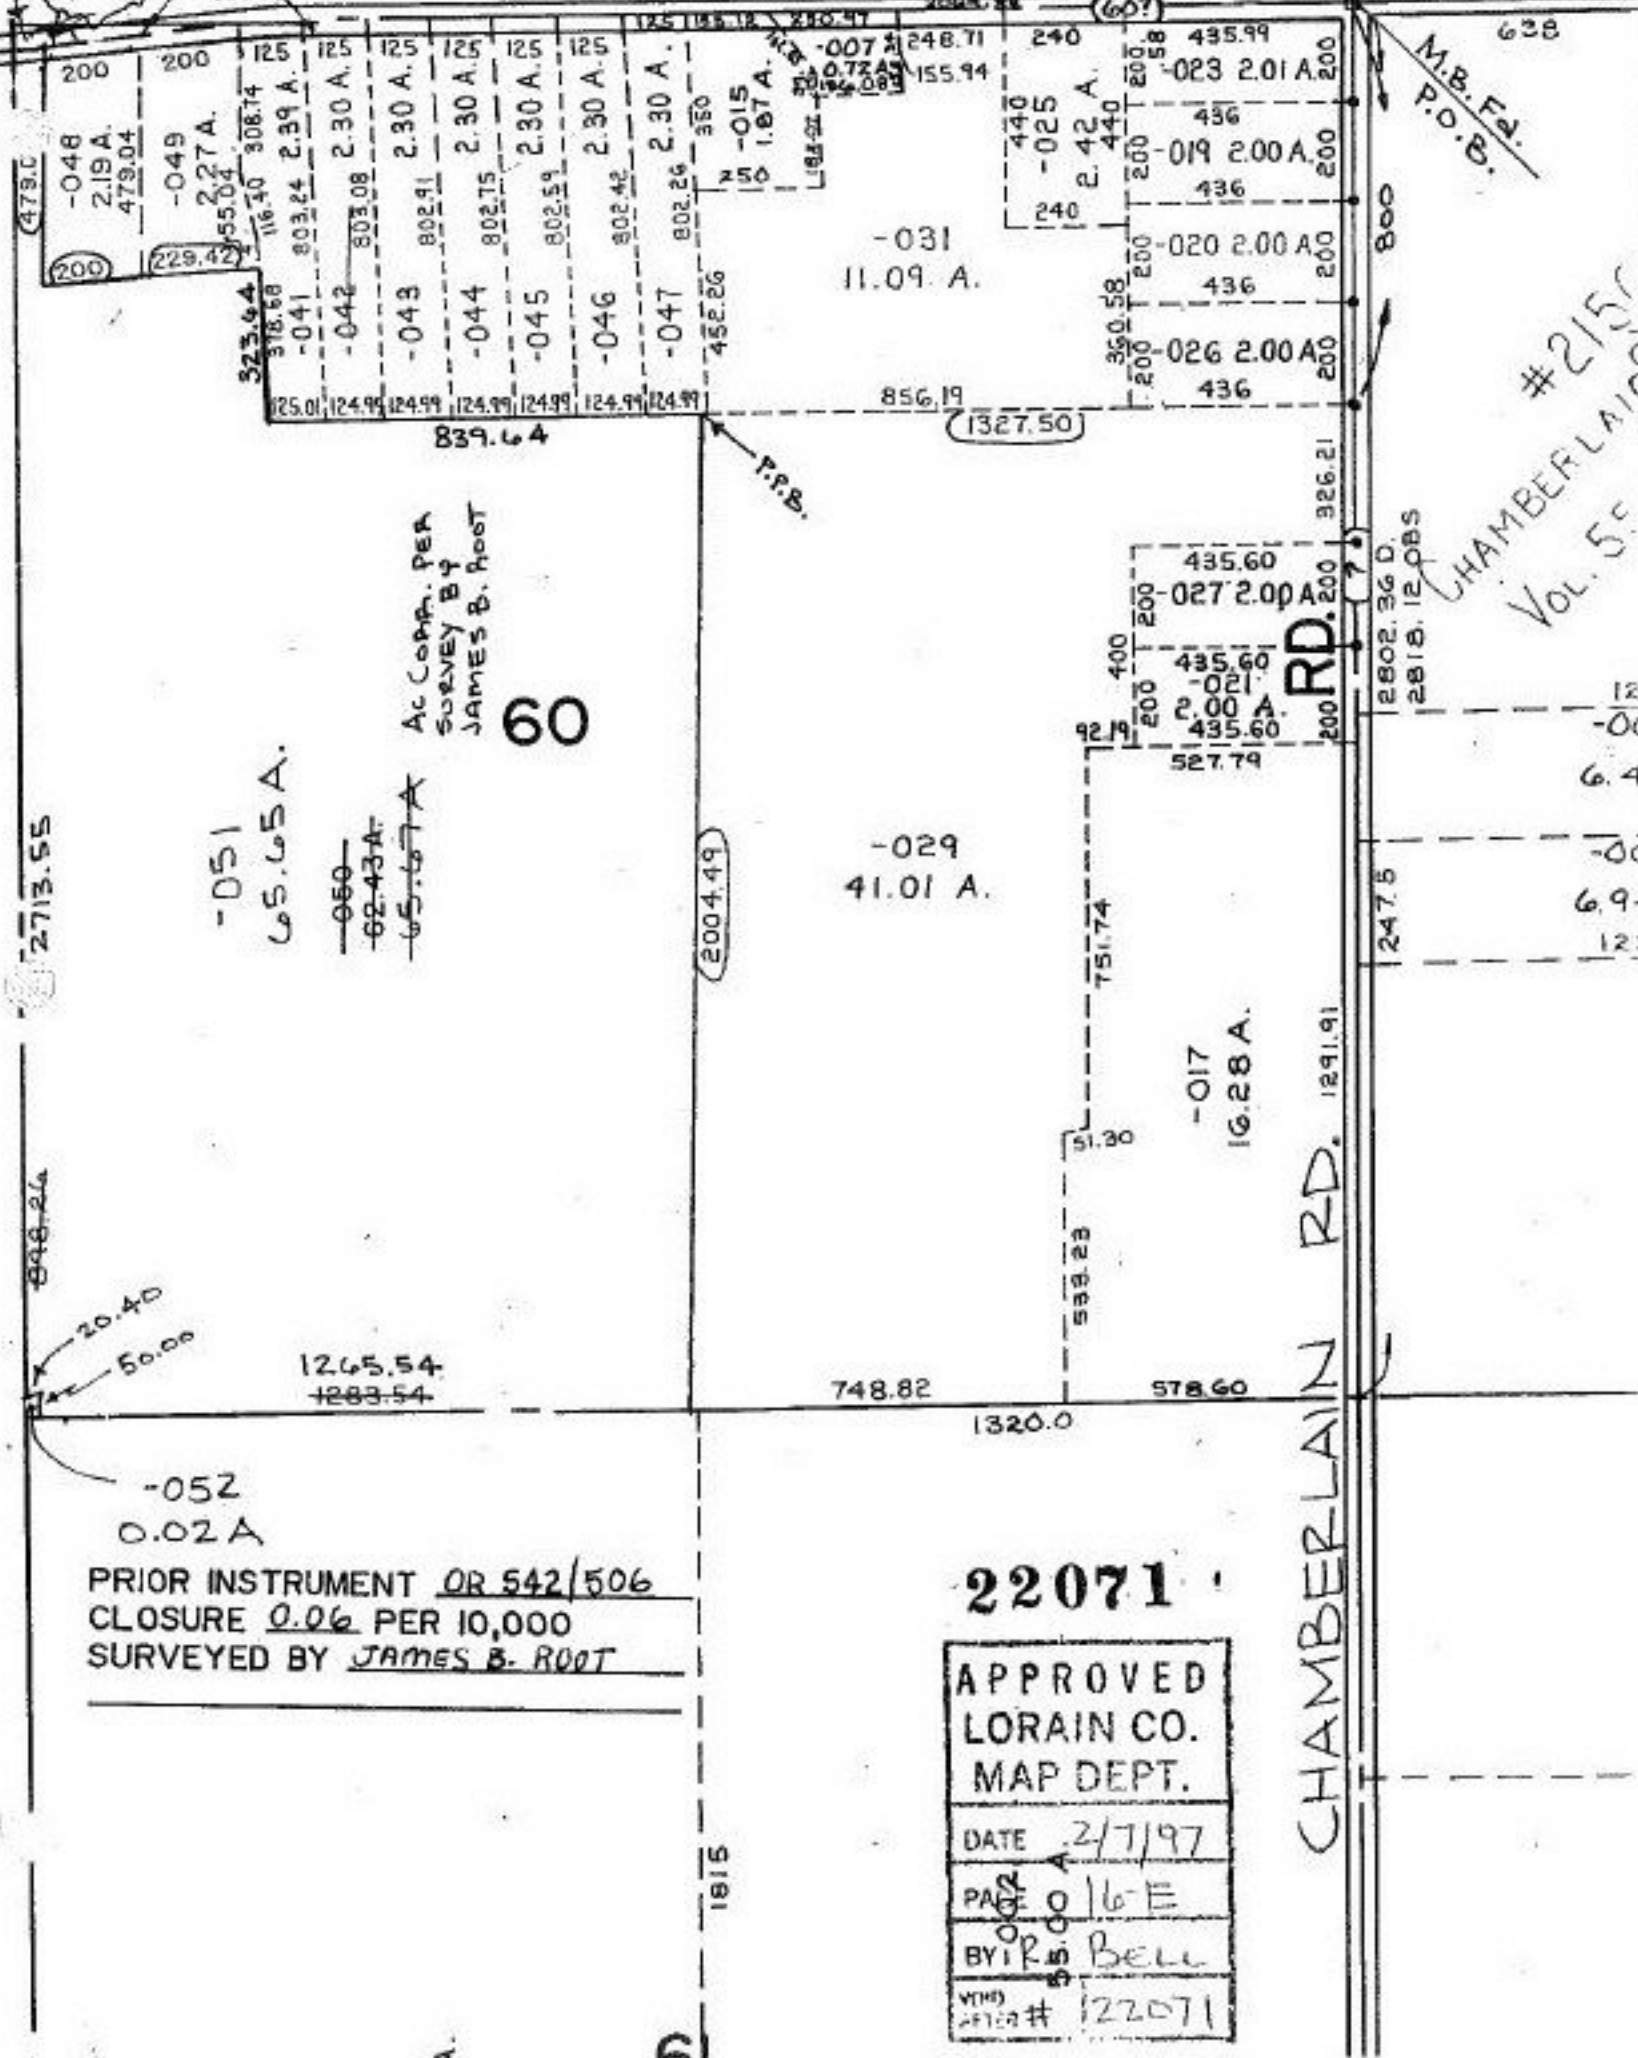

#2155
 CHAMBERLAIN
 Vol. 55

RD. 200

CHAMBERLAIN RD. 1291.91

2004.49

22071

APPROVED	
LORAIN CO.	
MAP DEPT.	
DATE	2/7/97
PAGE	016 E
BY	R. S. Bell
VIEW #	22071

PRIOR INSTRUMENT OR 542/506
 CLOSURE 0.06 PER 10,000
 SURVEYED BY JAMES B. ROOT

2713.55

-051

65.65 A.

-050

62.43 A.

65.67 A.

Ac Comp. PER
 SURVEY BY
 JAMES B. ROOT

60

1265.54
 1283.54

748.82

1320.0

578.60

1815

247.5

2802.36 D
 2818.12 P.B.S

6.4
 6.9
 12.3

638

800

326.21

200

200

479.0

200

229.42

323.64

318.68

116.30

308.74

803.24

803.08

802.91

802.75

802.59

802.42

802.26

452.26

125.01

124.99

124.99

