


SEE 4-B

#22073

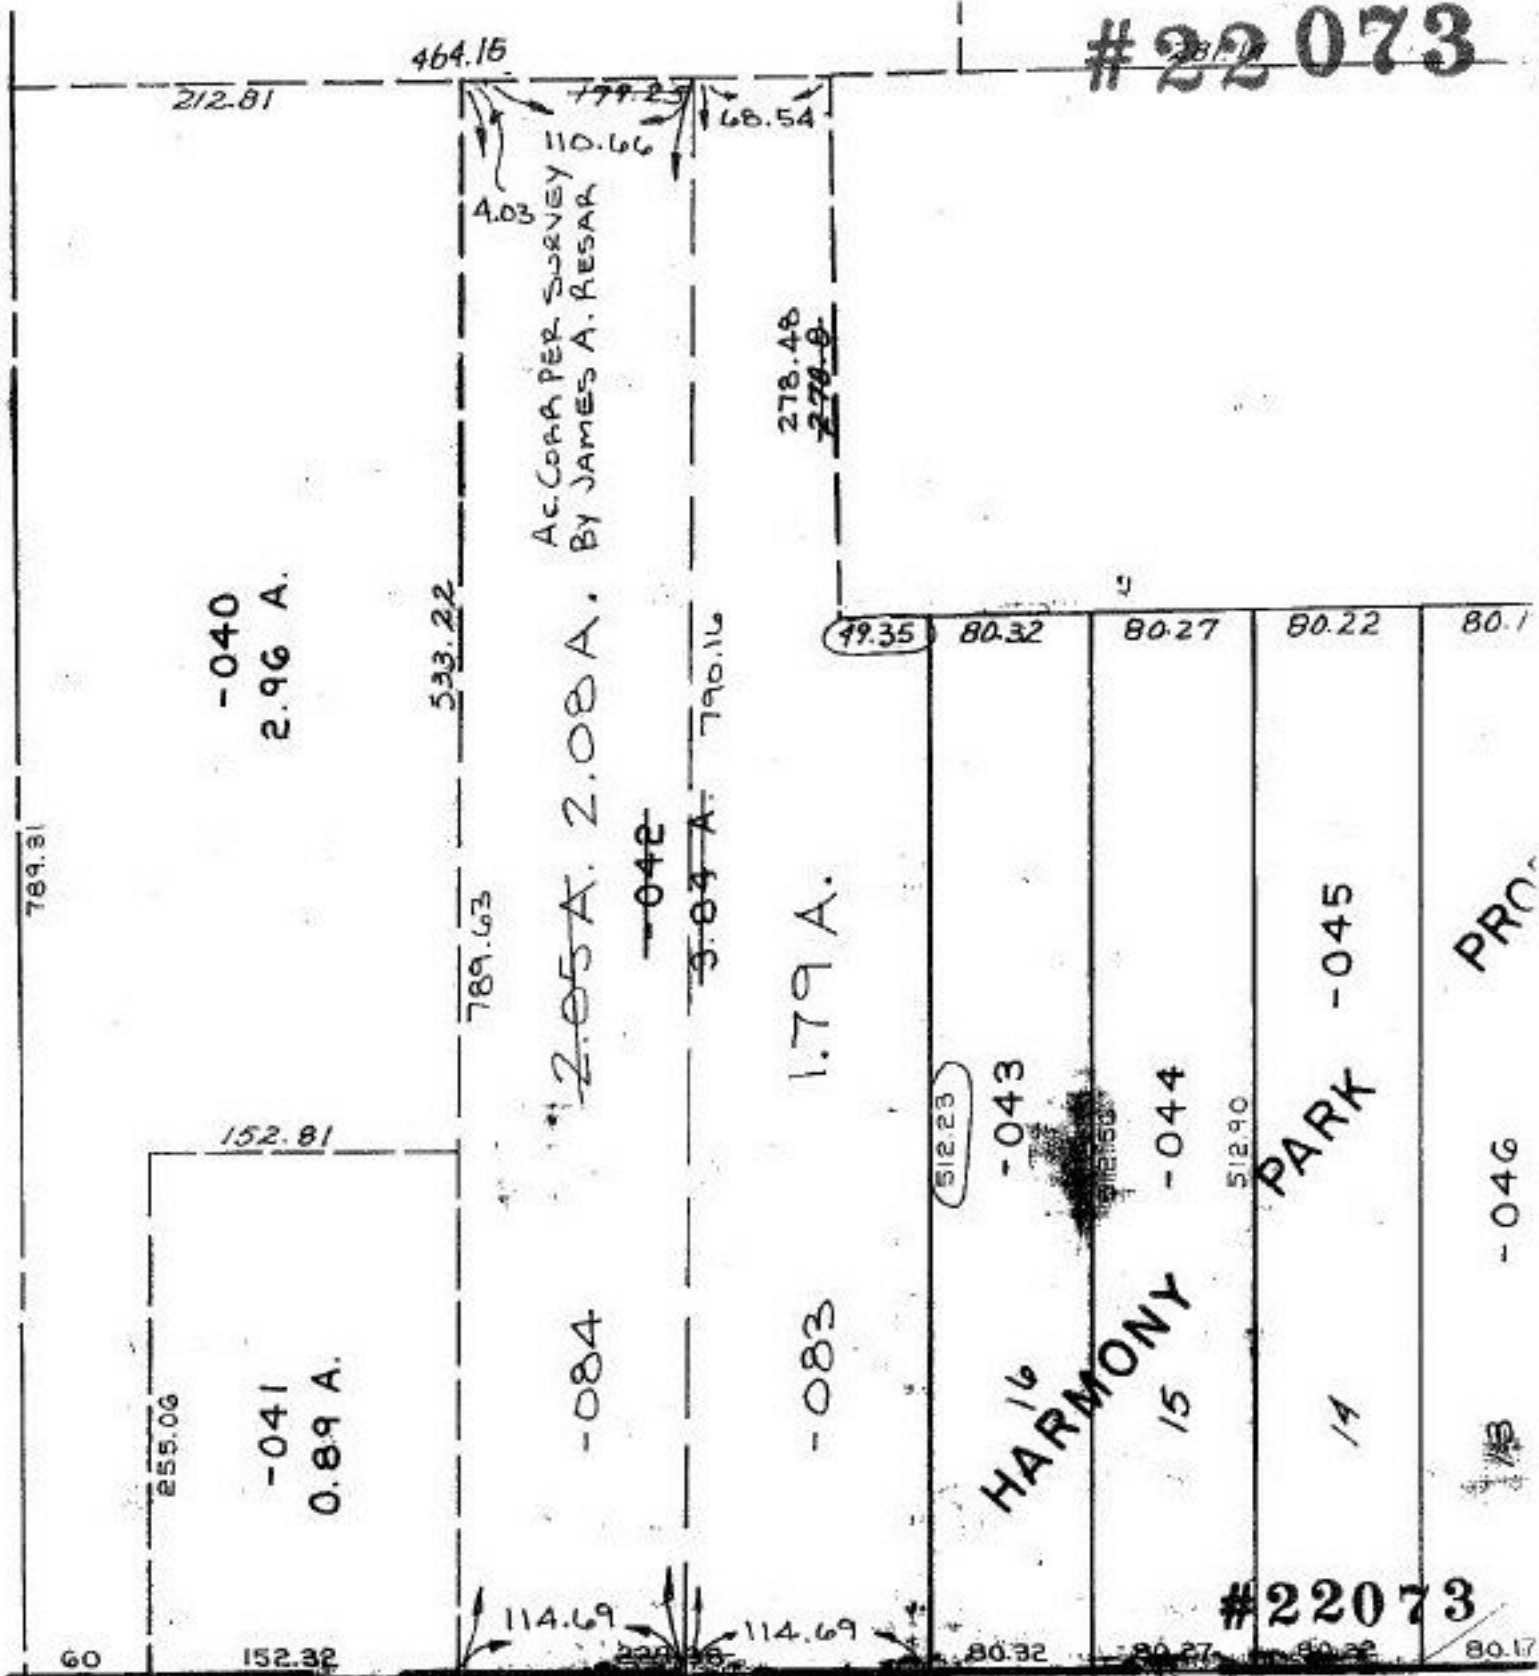

WEBBER

DEDICATION PLAT

#22073

1888.35 To M.B. Ed e
S.P. 83

APPROVED

LORAIN CO.
MAP DEPT.

DATE 2-20-97

PAGE 4-00-017A

BY R. BELL

MAP # 22073