


#22083

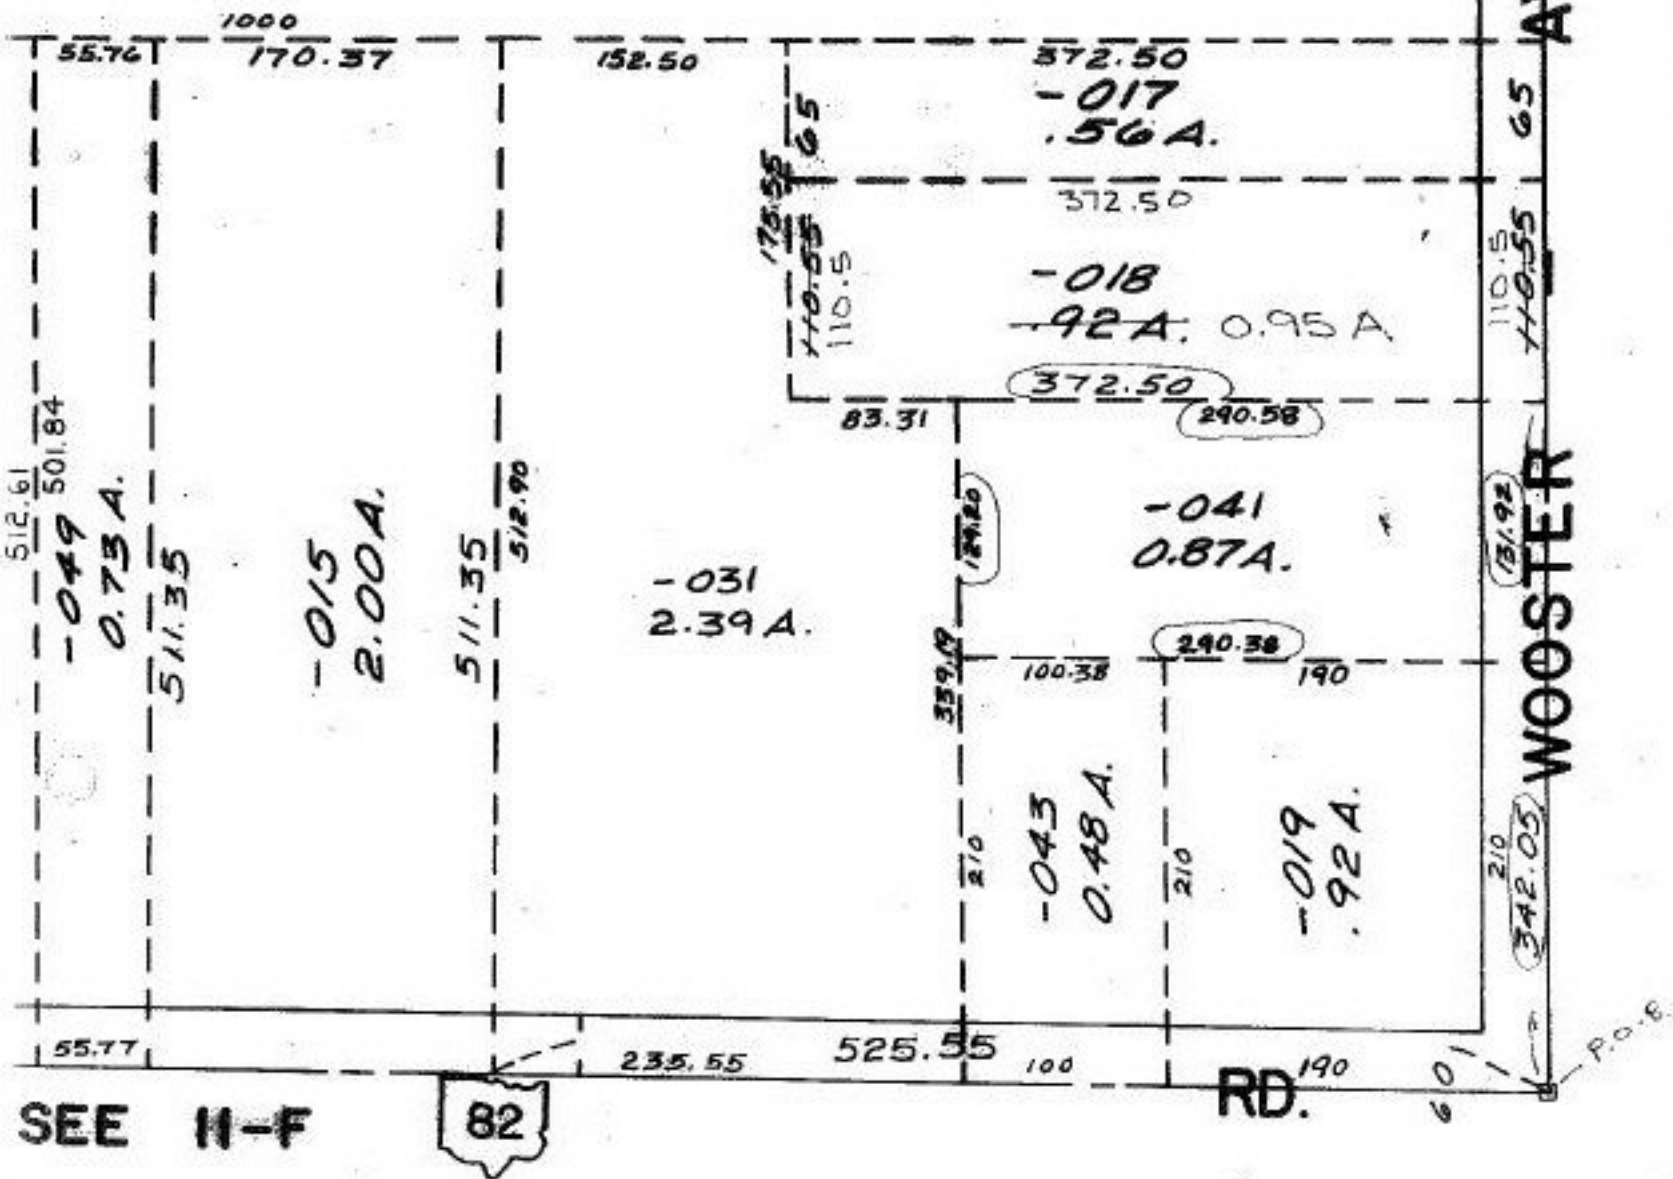

**ACREAGE  
CORRECTION**

PER DESCRIPTION  
IN D.V. 661 P. 408

**E. 1/2 LOT 55**

#22083-D

APPROVED  
LORAIN CO.  
MAP DEPT.  
DATE 3-3-97  
PAGE 11-00-055B  
BY F. BELL  
MAP # 22083-D

RE VISE

**11-0**