


#22083

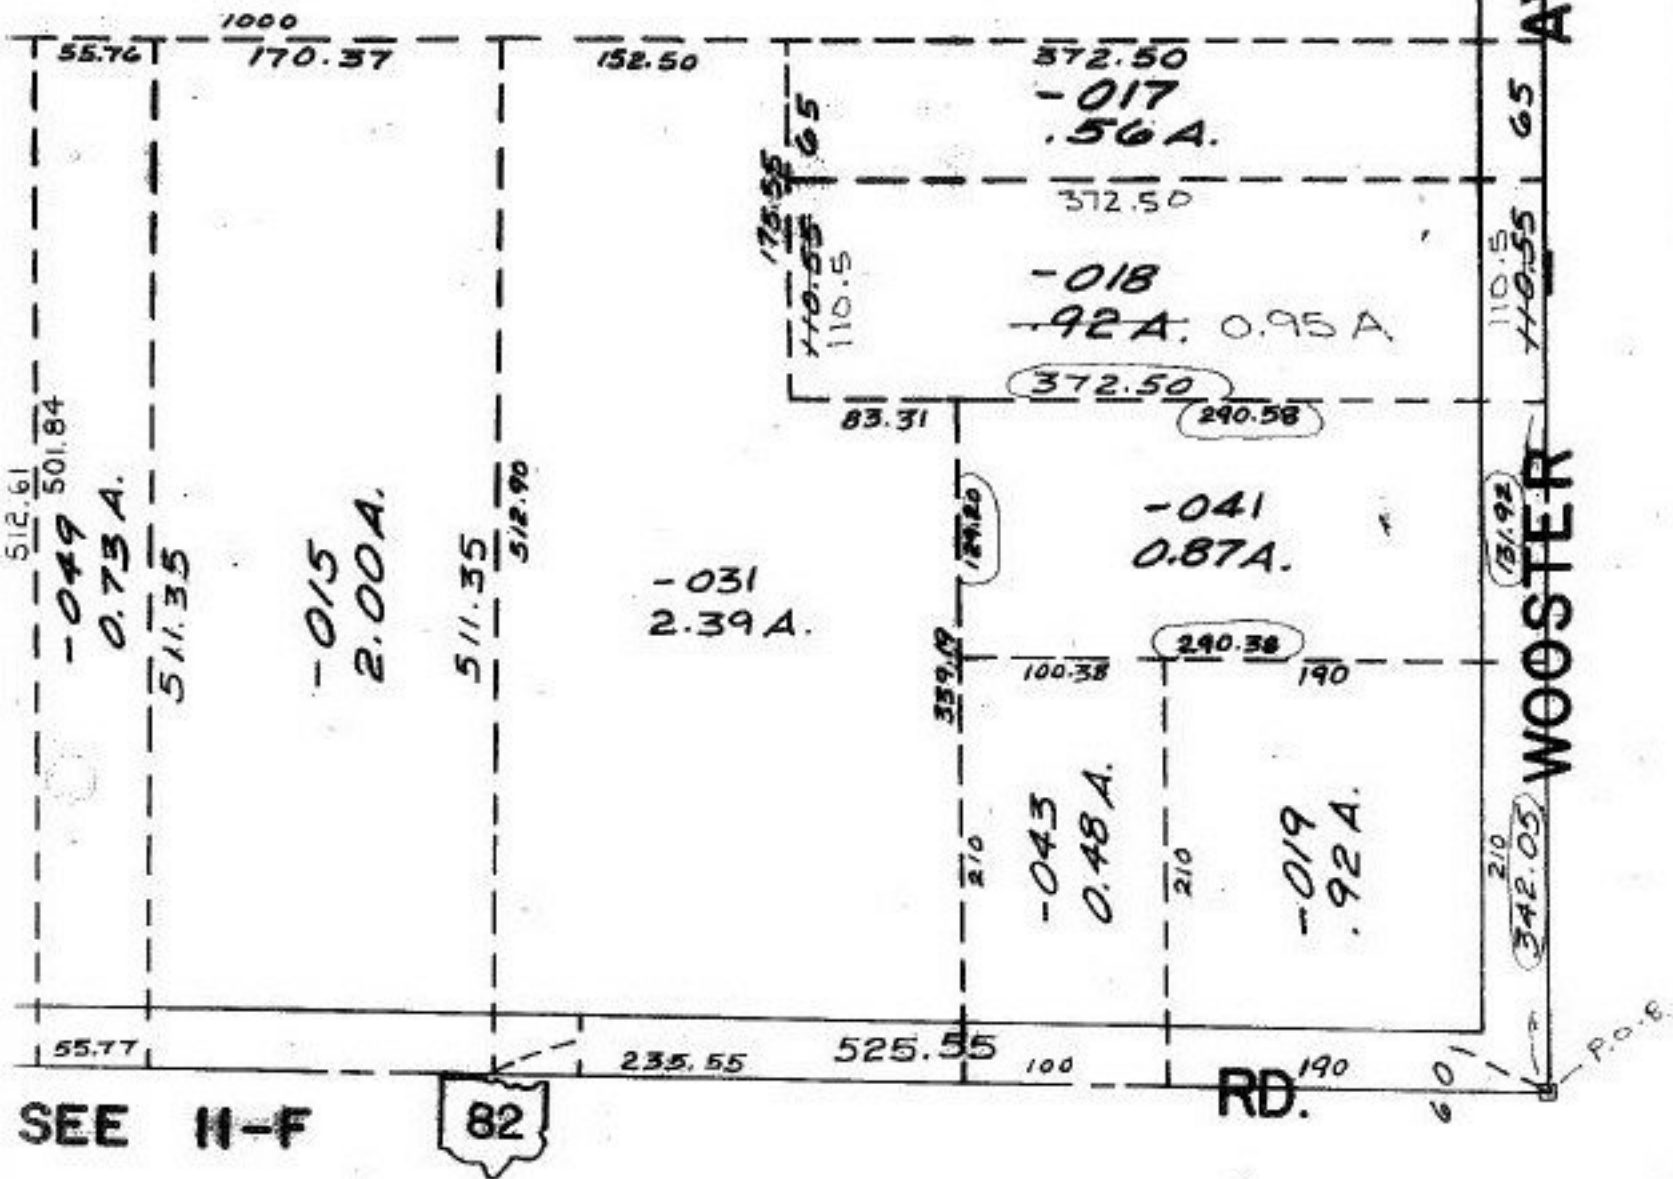

**ACREAGE
CORRECTION**

PER DESCRIPTION
IN D.V. 661 P. 408

E. 1/2 LOT 55

#22083-D

APPROVED
LORAIN CO.
MAP DEPT.
DATE 3-3-97
PAGE 11-00-055B
BY F. BELL
MAP # 22083-D

RE VISE

11-0