


#22086

1015.00 to 1100.00  
E JAYCOX ROAD

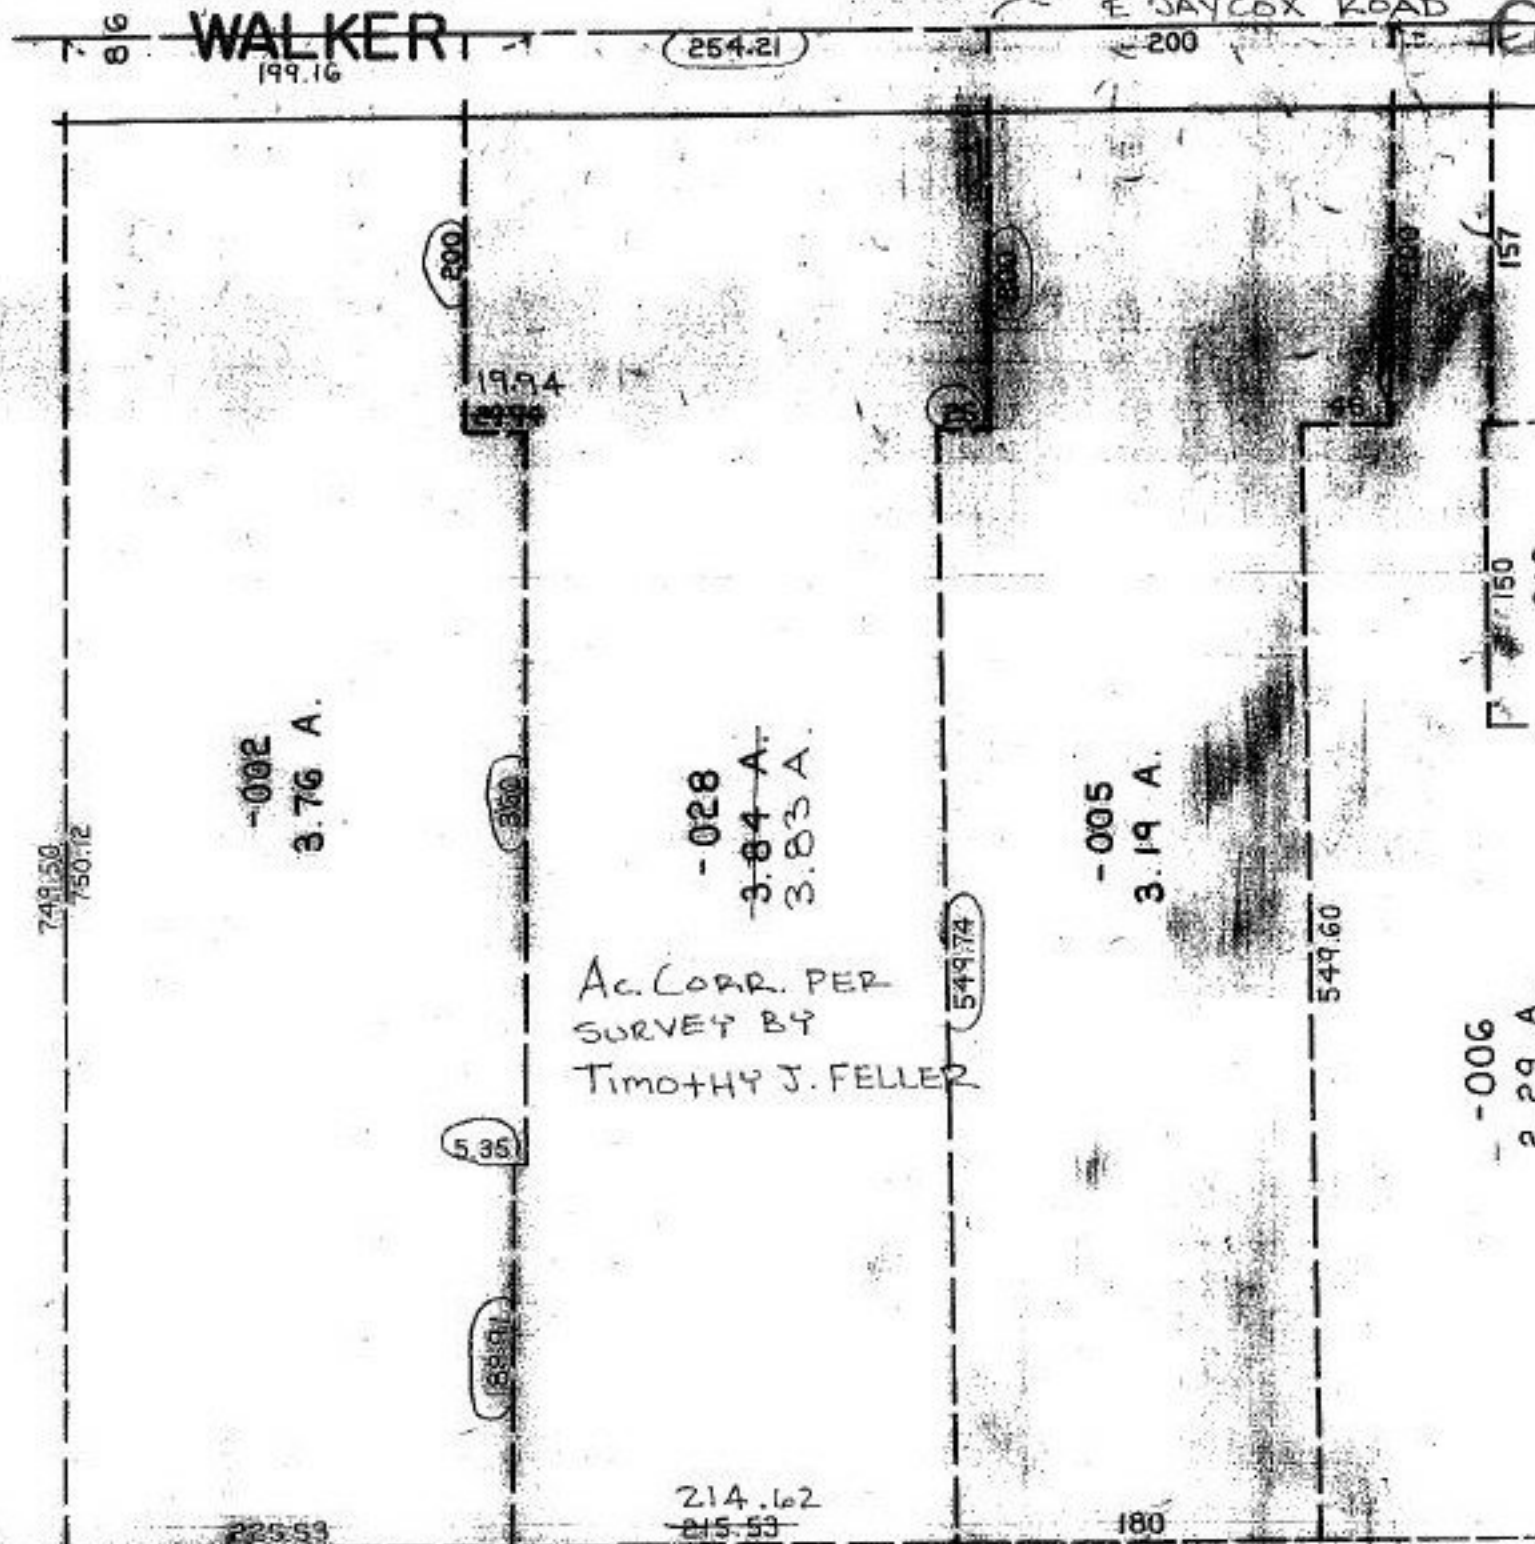

**ACREAGE  
CORRECTION**

#22086-D

APPROVED	
LORAIN CO. MAP DEPT.	
DATE 2-26-97	
PAGE 04-00-020B	
BY R. BELL	
VOID DATE	# 22086-D