


JONES ROAD

#22089

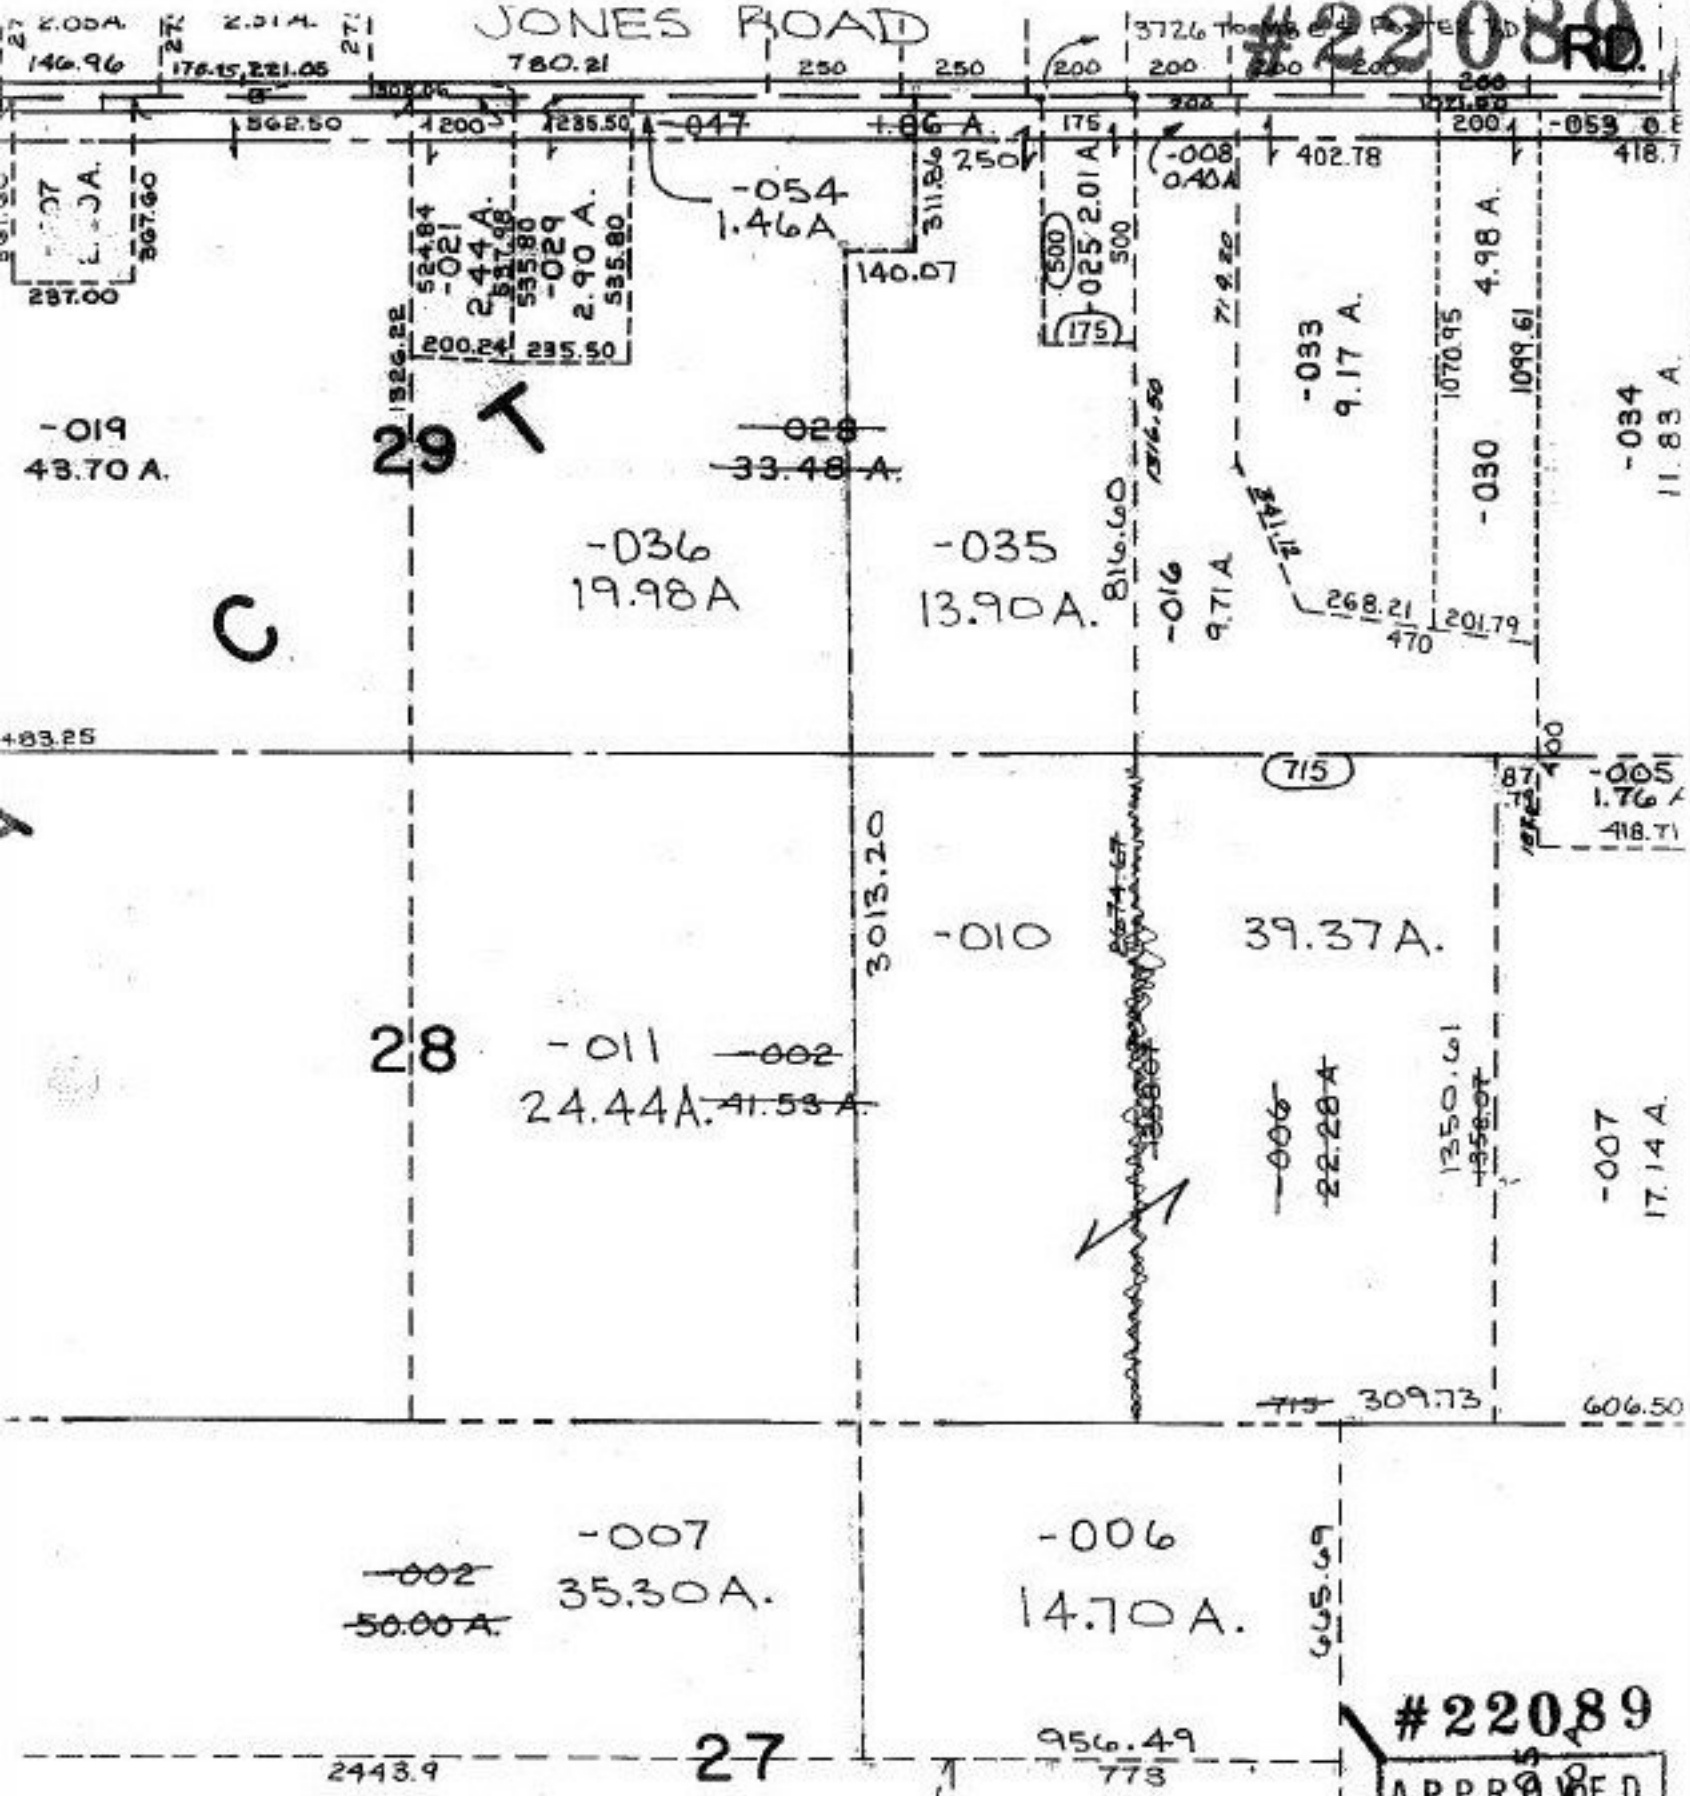

#22089

| |
|--------------------|
| APPROVED |
| LORAIN CO. |
| MAP DEPT. |
| DATE 3-3-97 |
| PAGE 19-6 |
| BY R. BELL |
| VOID AFTER # 22089 |