


#22097
NO. 22097

PARENT PARCEL: 11-00-065-000-023 & -024
CHILD PARCEL: 11-00-065-000-025, 026, 028
STARTING POINT: PK NAIL SET NE COR O.L. 65 & CL ELYRIA TWINSBURG ROAD

ELYRIA TWINSBURG RD (SR 82)

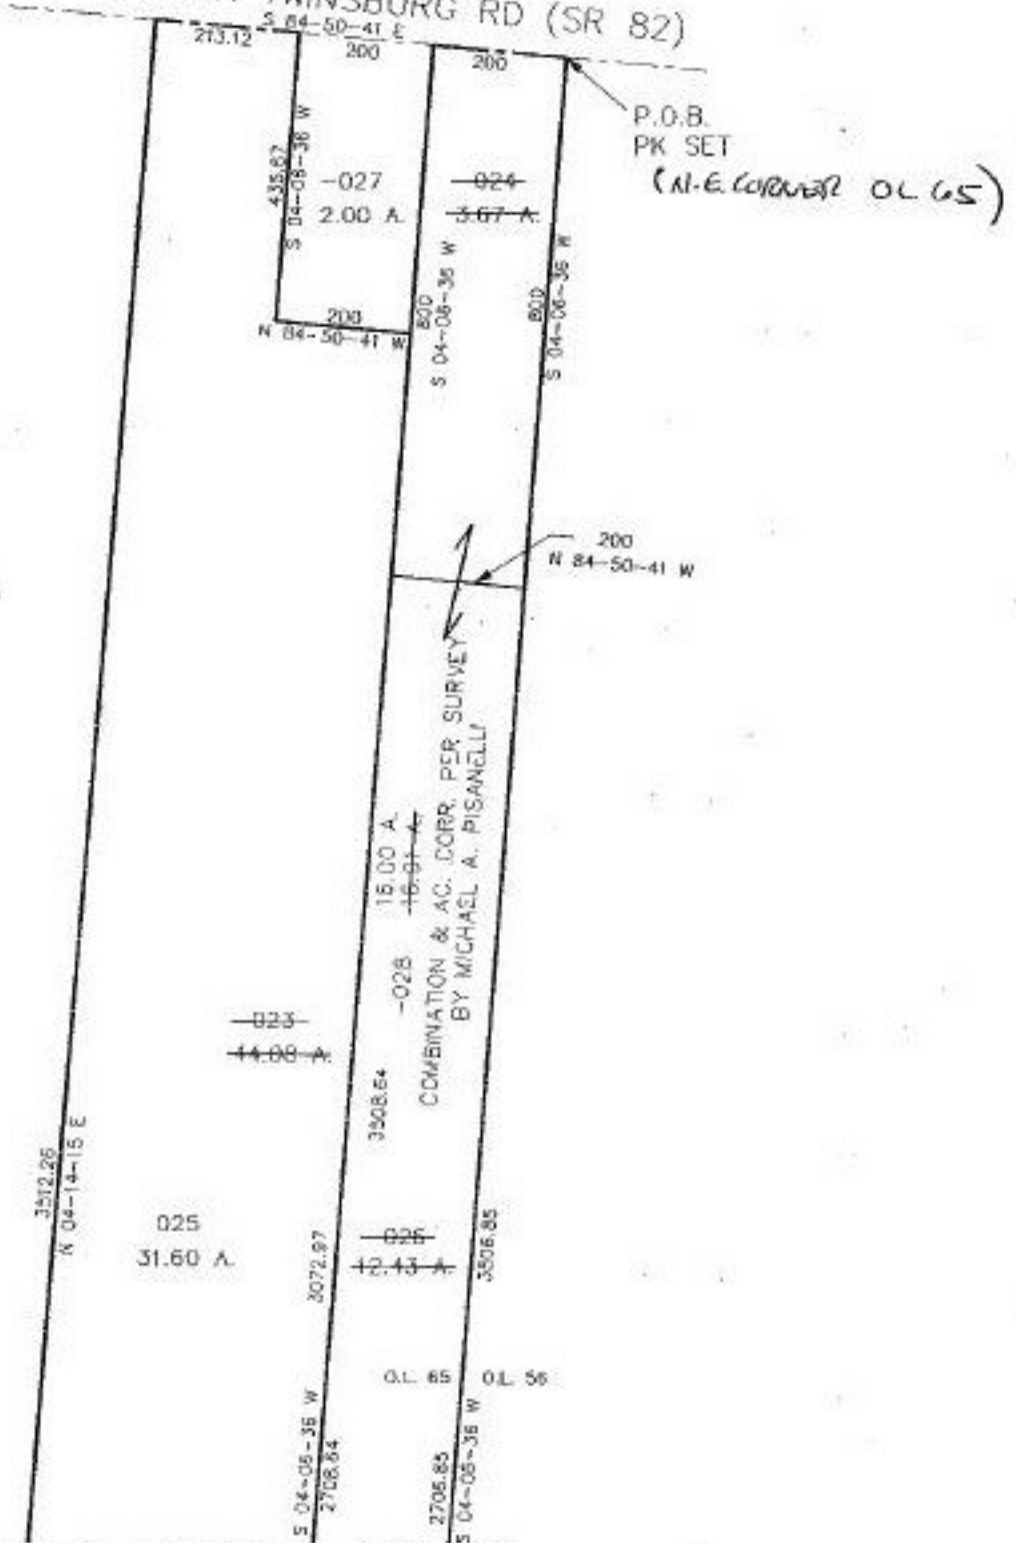

SEE SHEET NO. 2



SPLITS/DEEDS PROCESSED
LORAIN COUNTY TAX MAP DEPARTMENT
226 MIDDLE AVE. ELYRIA, OHIO

SURVEYED BY: MICHAEL A. PISANELLI
CLOSURE: 0.02:10.000
MAP PAGE(S): 11-F (NORTH)
APPROVED BY: REE DATE: 03/27/97
SCALE: 1" = 300'