


PARENT PARCEL: 11-00-065-000-023 & -024
 CHILD PARCEL: 11-00-065-000-025, 026, 028
 STARTING POINT: PK NAIL SET AT NE CORNER O.L. 65 & CL ELYRIA TWINSBURG ROAD

#22097
 NO. 22097



SEE SHEET NO. 1

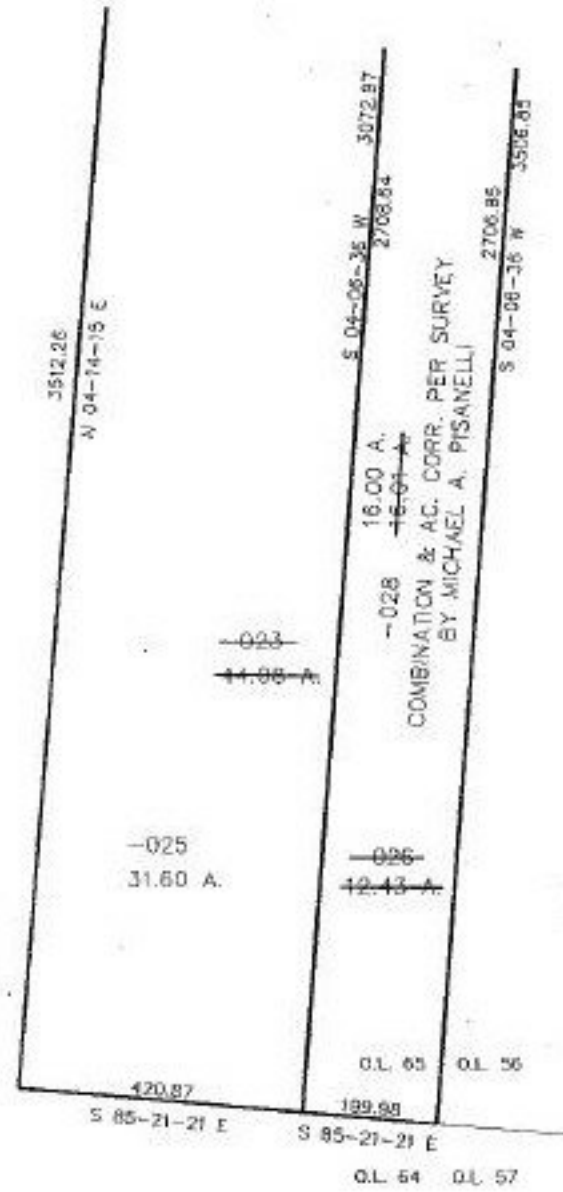

SPLITS/DEEDS PROCESSED
 LORAIN COUNTY TAX MAP DEPARTMENT
 226 MIDDLE AVE. ELYRIA, OHIO

SURVEYED BY: MICHAEL A. PISANELLI
 CLOSURE: 0.02:10.000
 MAP PAGE(S): 11-F (NORTH)
 APPROVED BY: RFB DATE: 03/27/97
 SCALE: 1" = 300'