


PARENT PARCEL: 07-00-038-000-046

CHILD PARCEL: 07-00-038-000-122 & -123

STARTING POINT: CL SUGAR RIDGE ROAD AT ELY. LINE VIOLET DUNCAN

NO. 22105-X

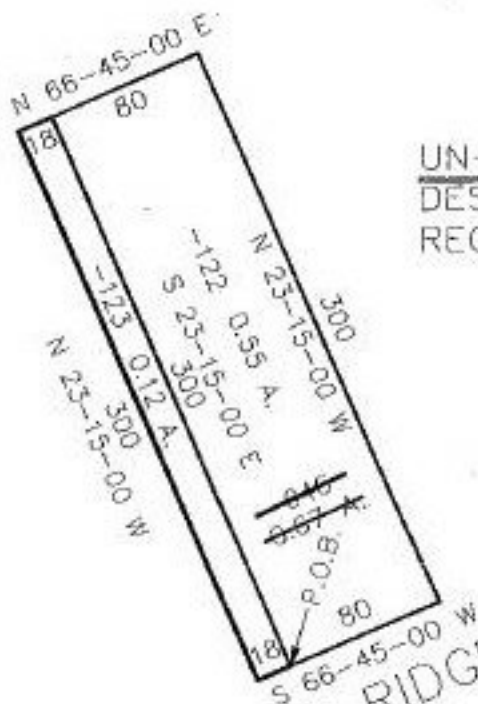

UN-COMBINATION PER SURVEY
DESCRIPTIONS PER J.W. WARDEN
REC. IN D.V.472/489 & D.V.673/323Z

SUGAR RIDGE ROAD

EFFECTIVE ALS
R 9-5-97

R. Beel
5/2/97



SPLITS/DEEDS PROCESSED
LORAIN COUNTY TAX MAP DEPARTMENT
226 MIDDLE AVE. ELYRIA, OHIO

SURVEYED BY: J.W. WARDEN
CLOSURE: 0.00 : 10.000
MAP PAGE(S): 7-00-038B
APPROVED BY: RFB DATE: 03/24/97
SCALE: 1" = 100'