


#22105
NO. 22105

PARENT PARCEL: 11-00-099-000-263
CHILD PARCEL: 11-00-099-000-305 & 306
STARTING POINT: SOUTHWEST CORNER O.L. 99

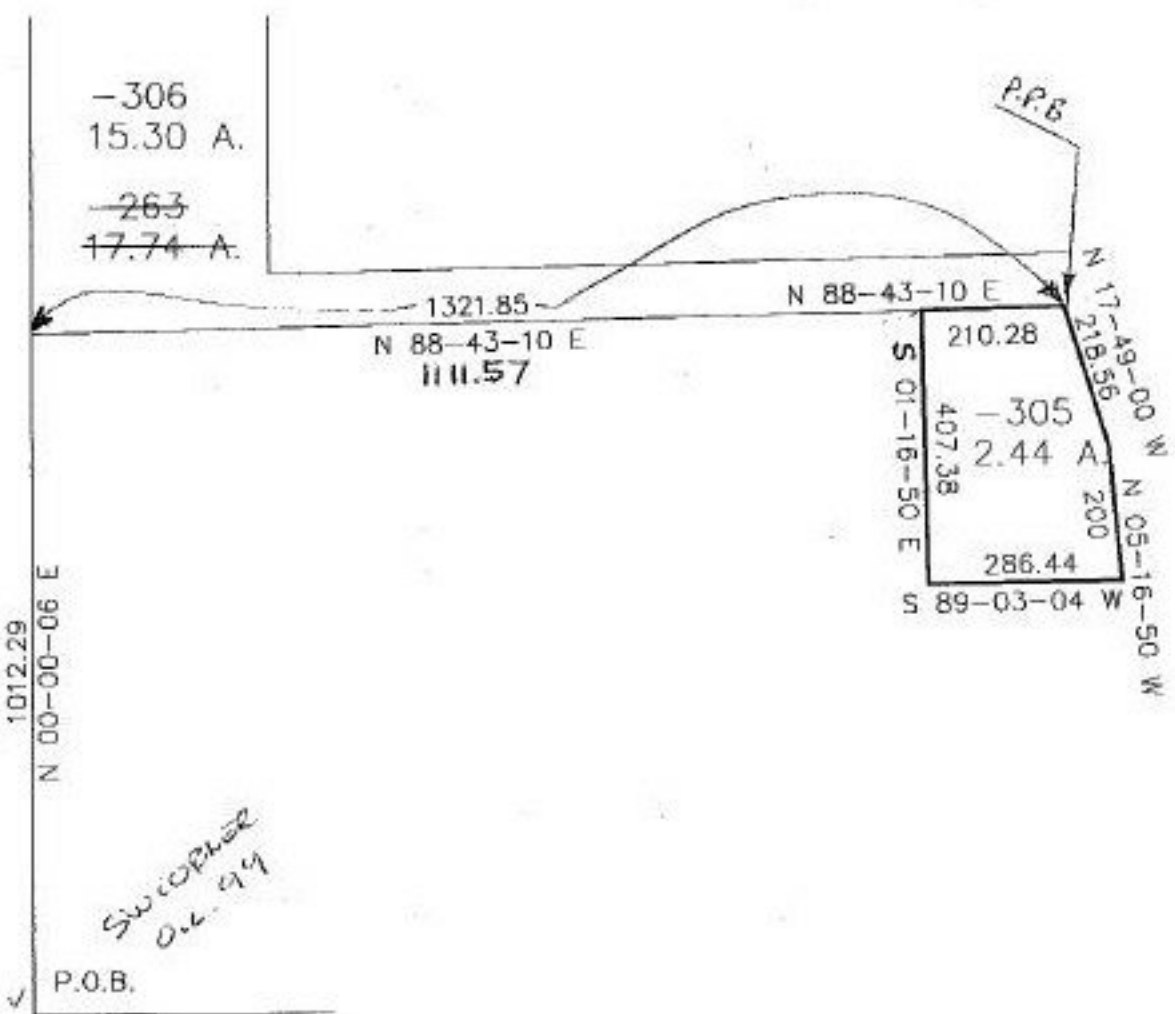

SPLITS/DEEDS PROCESSED
LORAIN COUNTY TAX MAP DEPARTMENT
226 MIDDLE AVE. ELYRIA, OHIO

SURVEYED BY: THOMAS M. SNEZEK
CLOSURE: 0.04:10.000
MAP PAGE(S): 11-E SOUTH
APPROVED BY: RFB DATE: 06/16/97
SCALE: 1" = 300'