


PARENT PARCEL: 18-00-020-000-093 & 094  
 CHILD PARCEL: 18-00-020-000-095  
 STARTING POINT: IP FD AT SOUTHEAST CORNER D.L. 20

**NO. 22114**



~~-097~~  
 21.93 A.  
~~-093~~  
~~28.67 A.~~  
~~-094~~  
 11.36 A.  
 -096  
 10.42 A.

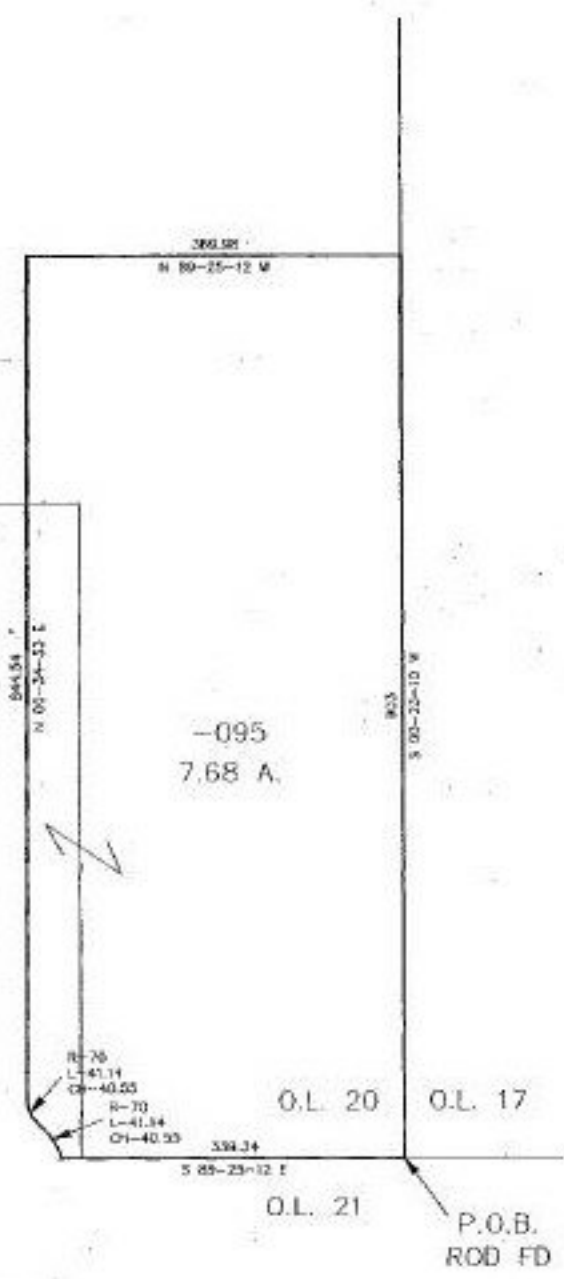

**SPLITS/DEEDS PROCESSED**  
 LORAIN COUNTY TAX MAP DEPARTMENT  
 226 MIDDLE AVE. ELYRIA, OHIO

SURVEYED BY: ROBERT A. SANFORD  
 CLOSURE: 0.01 : 10,000  
 MAP PAGE(S): 18-00-0200  
 APPROVED BY: RFB DATE: 03/26/97  
 SCALE: 1" = 200'