

#22115
NO. 22115

PARENT PARCEL: 10-00-001-101-033, 034

CHILD PARCEL: 10-00-001-101-071, 073

STARTING POINT: cl. Russia Rd, also being the SE line of Section No. 1




RUSSIA TWP
CARUSLE TWP

P.O.B.
MDN FD

RUSSIA ROAD

1334.57
N 89-48-14 E

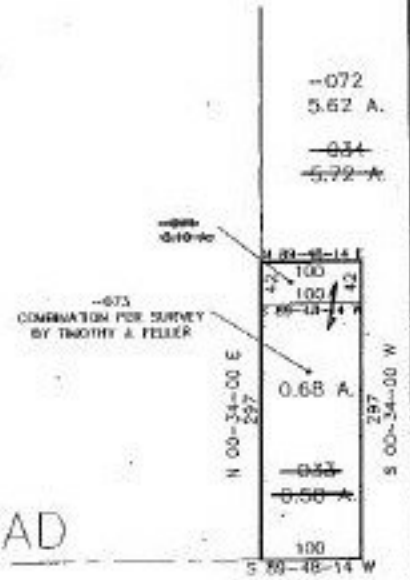

SPLITS/DEEDS PROCESSED
LORAIN COUNTY TAX MAP DEPARTMENT
226 MIDDLE AVE. ELYRIA, OHIO

SURVEYED BY: Timothy J. Feller
CLOSURE: 0.00 per 10,000
MAP PAGE(S): 10-00-001-E
APPROVED BY: kac DATE: 3-26-97
SCALE: 1" = 200'