

# #22125

PARENT PARCEL: 03-00-031-105-023

CHILD PARCEL: 03-00-031-105-050, 051, 052, 053

STARTING POINT: INTERSECTION ROOT ROAD & PIN OAK DRIVE

NO. 22125



ACREAGE CORRECTION PER SURVEY BY NORMAN R. HUBA


-053

1.00 A.

1.03 A.

ROOT ROAD

P.O.B.  
PIN OAK DRIVE

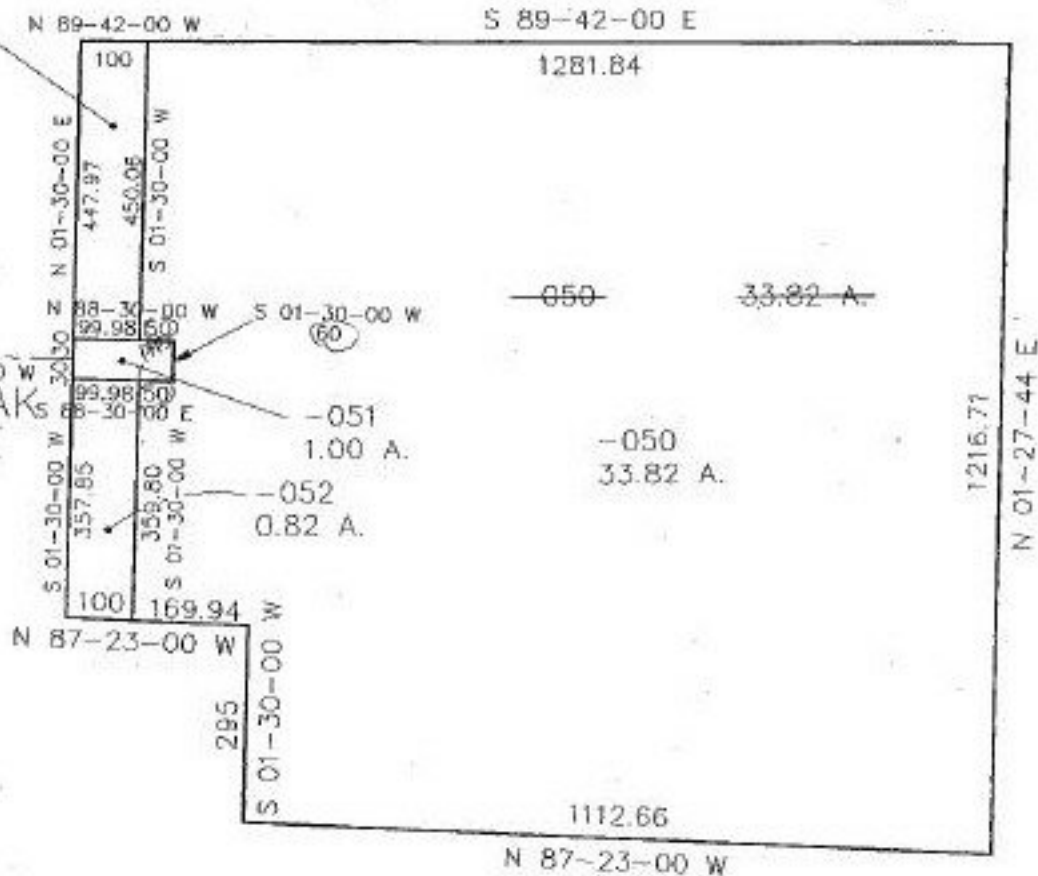

SPLITS/DEEDS PROCESSED  
LORAIN COUNTY TAX MAP DEPARTMENT  
226 MIDDLE AVE. ELYRIA, OHIO

SURVEYED BY: NORMAN R. HUBA

CLOSURE: 0.04 : 10,000

MAP PAGE(S): 03-00-031A

APPROVED BY: REB DATE: 22125

SCALE: 1" = 300'