

#22132
NO. 22132

PARENT PARCEL: 13-08-003-000-010
CHILD PARCEL: 13-08-003-000-011 & -012
STARTING POINT: c.L. of Baird Rd. & c.L. of Betts Rd.

BETTS ROAD

P.O.B.
IP FD




*This split happened
in the wrong tract
O.L. It should have come
out of #3-09-039-000-003
and become 022,023
This was fixed on
3/19/97 see #2228AX*

BAIRD ROAD 60'

714.10
S 00-18-43 W

300
S 00-18-43 W

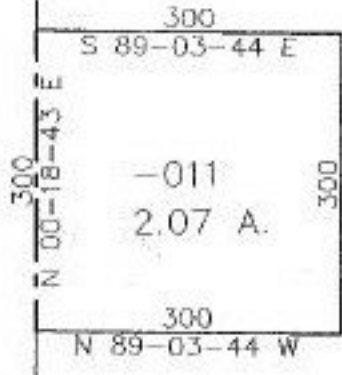

-010
65.92 A.

-012
63.85 A.



SPLITS/DEEDS PROCESSED
LORAIN COUNTY TAX MAP DEPARTMENT
226 MIDDLE AVE. ELYRIA, OHIO

SURVEYED BY: Thomas M. Sniezek
CLOSURE: 0.00 : 10.000
MAP PAGE(S): 13-E
APPROVED BY: kac/rfb DATE: 4-4-97
SCALE: 1" = 200'