


#22136

NO. 22136

PARENT PARCEL: 14-00-023-000-013

CHILD PARCEL: 14-00-023-000-014, -015 & -016

STARTING POINT: NW CORNER OF LOT # 23 (CL. OF KIPTON-NICKLE PLATE RD.)

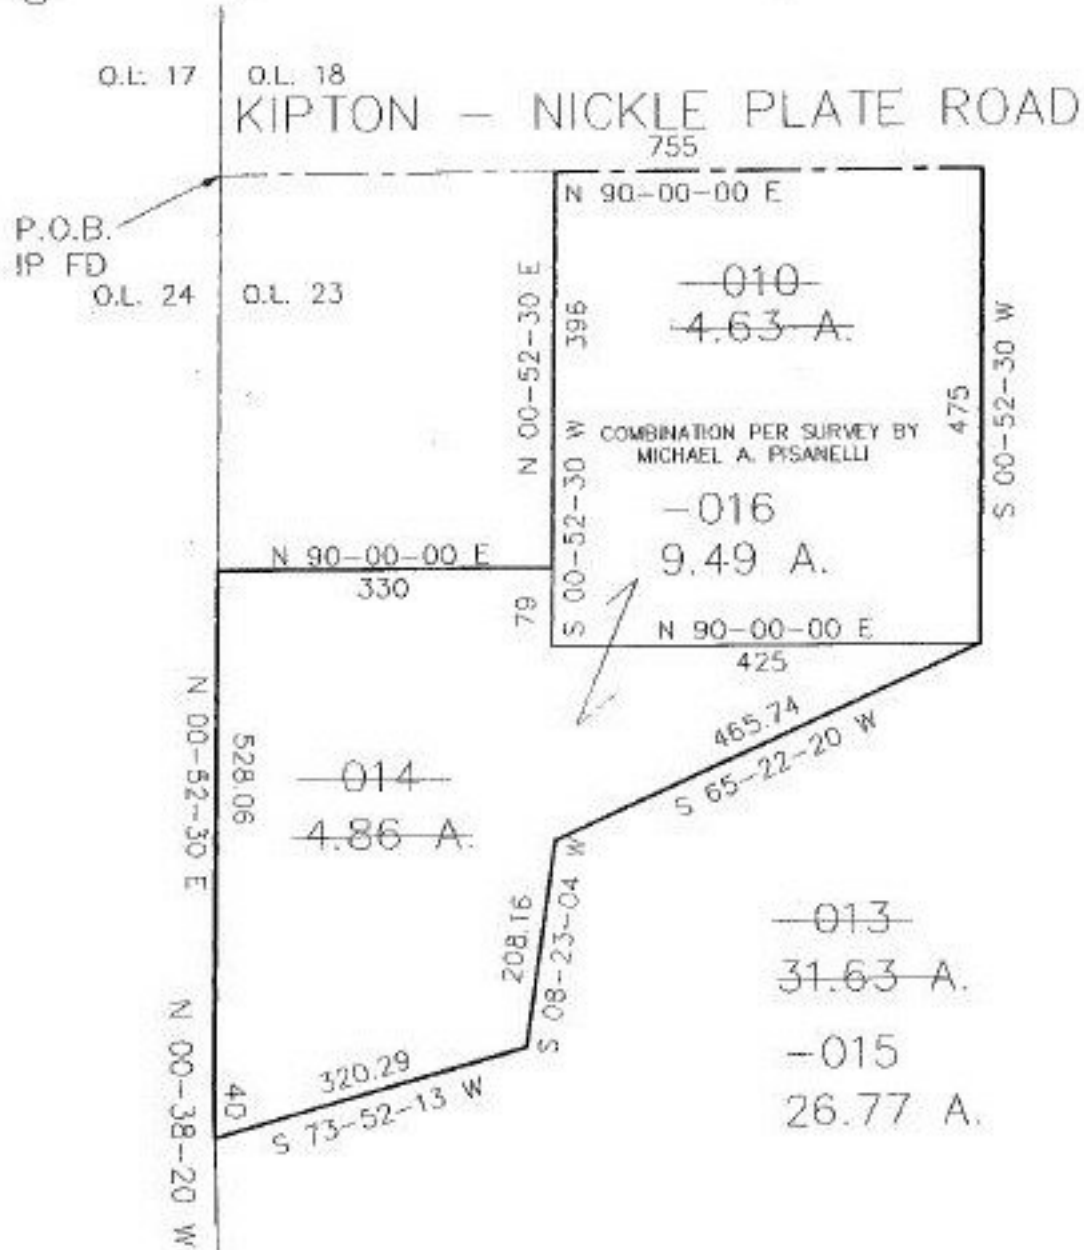

**SPLITS/DEEDS PROCESSED**  
 LORAIN COUNTY TAX MAP DEPARTMENT  
 226 MIDDLE AVE. ELYRIA, OHIO

SURVEYED BY: MICHAEL A. PISANELLI  
 CLOSURE: 0.03 : 10,000  
 MAP PAGE(S): 14-C  
 APPROVED BY: KAC/RFB DATE: 4-4-97  
 SCALE: 1" = 200'