


SEE 3-00-110-B  
NORTH RIDGE 254 RD.

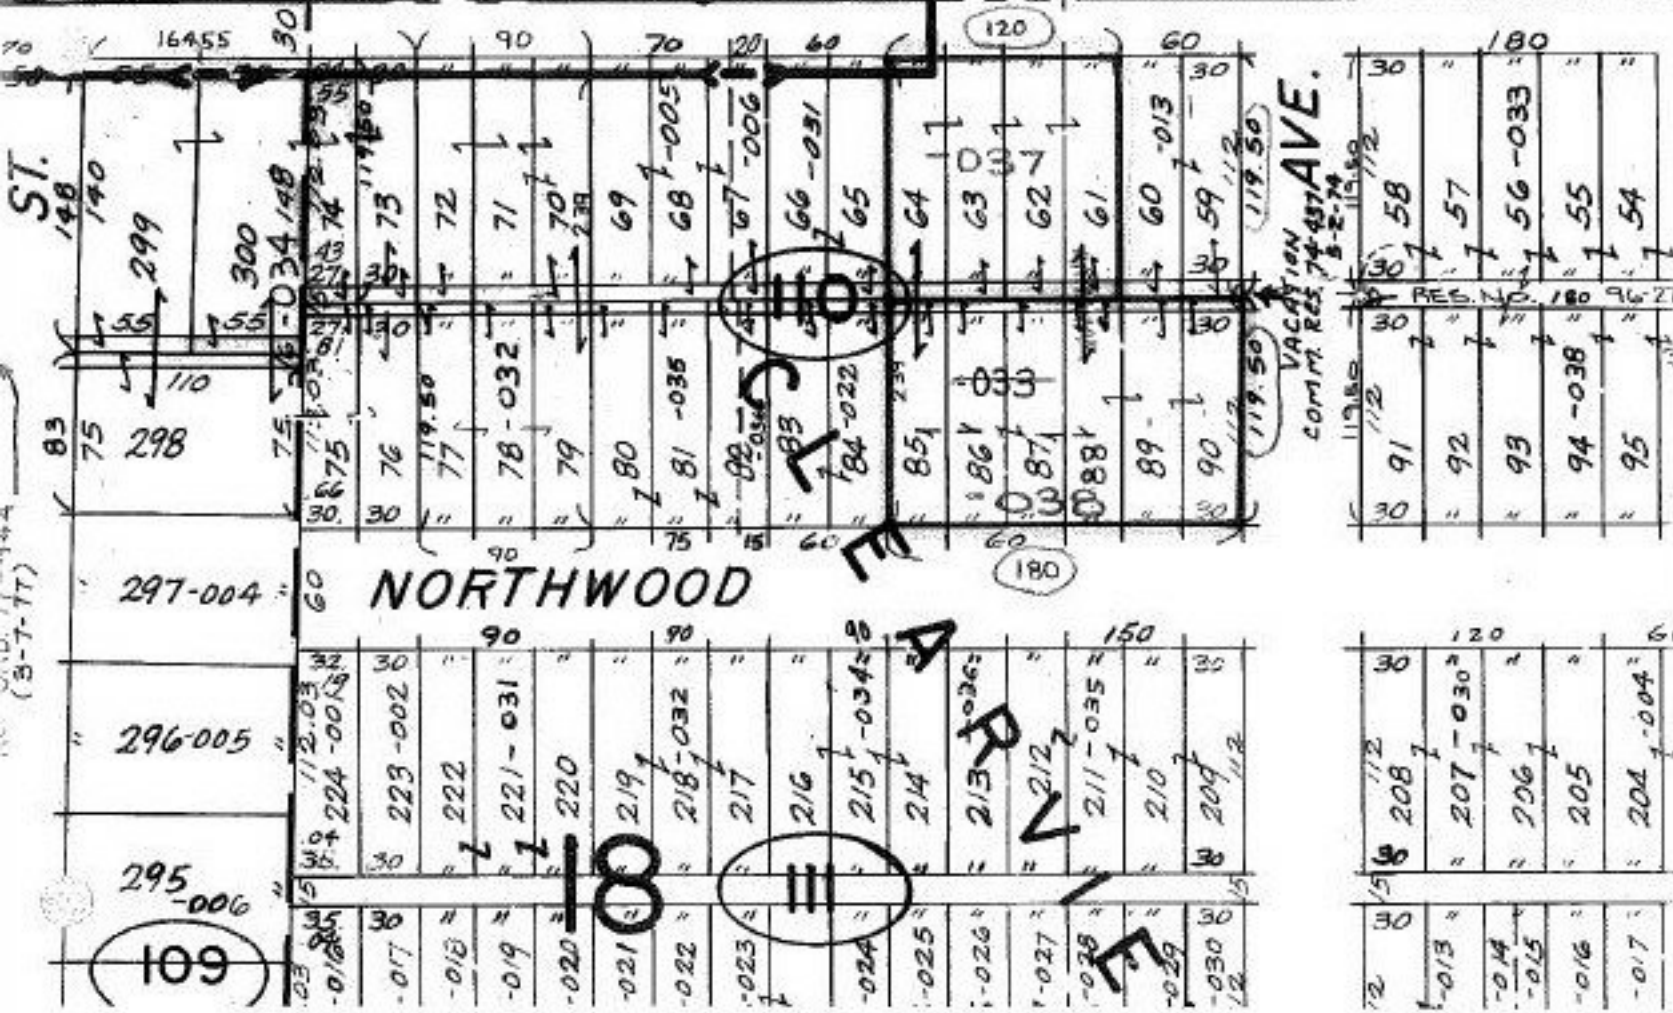

UN-COMBINATION  
PER DESCRIPTIONS  
IN O.R. 828 P. 797  
PARCELS NO. 5 & 6

EFFECTIVE 5/9/97

#22141-D  
DP 9-23-97

APPROVED LORAIN CO. MAP DEPT.
DATE 4-9-97
PAGE 6-7
BY R. Bell
VOID AFTER # 22141-D