


#22144

PARENT PARCEL: 01-00-023-000-043

CHILD PARCEL: 01-00-010-000-019 & 01-00-023-000-045

STARTING POINT: NE corner of subplot 4 on s right of way of Deer Tail Lane

NO. 22144

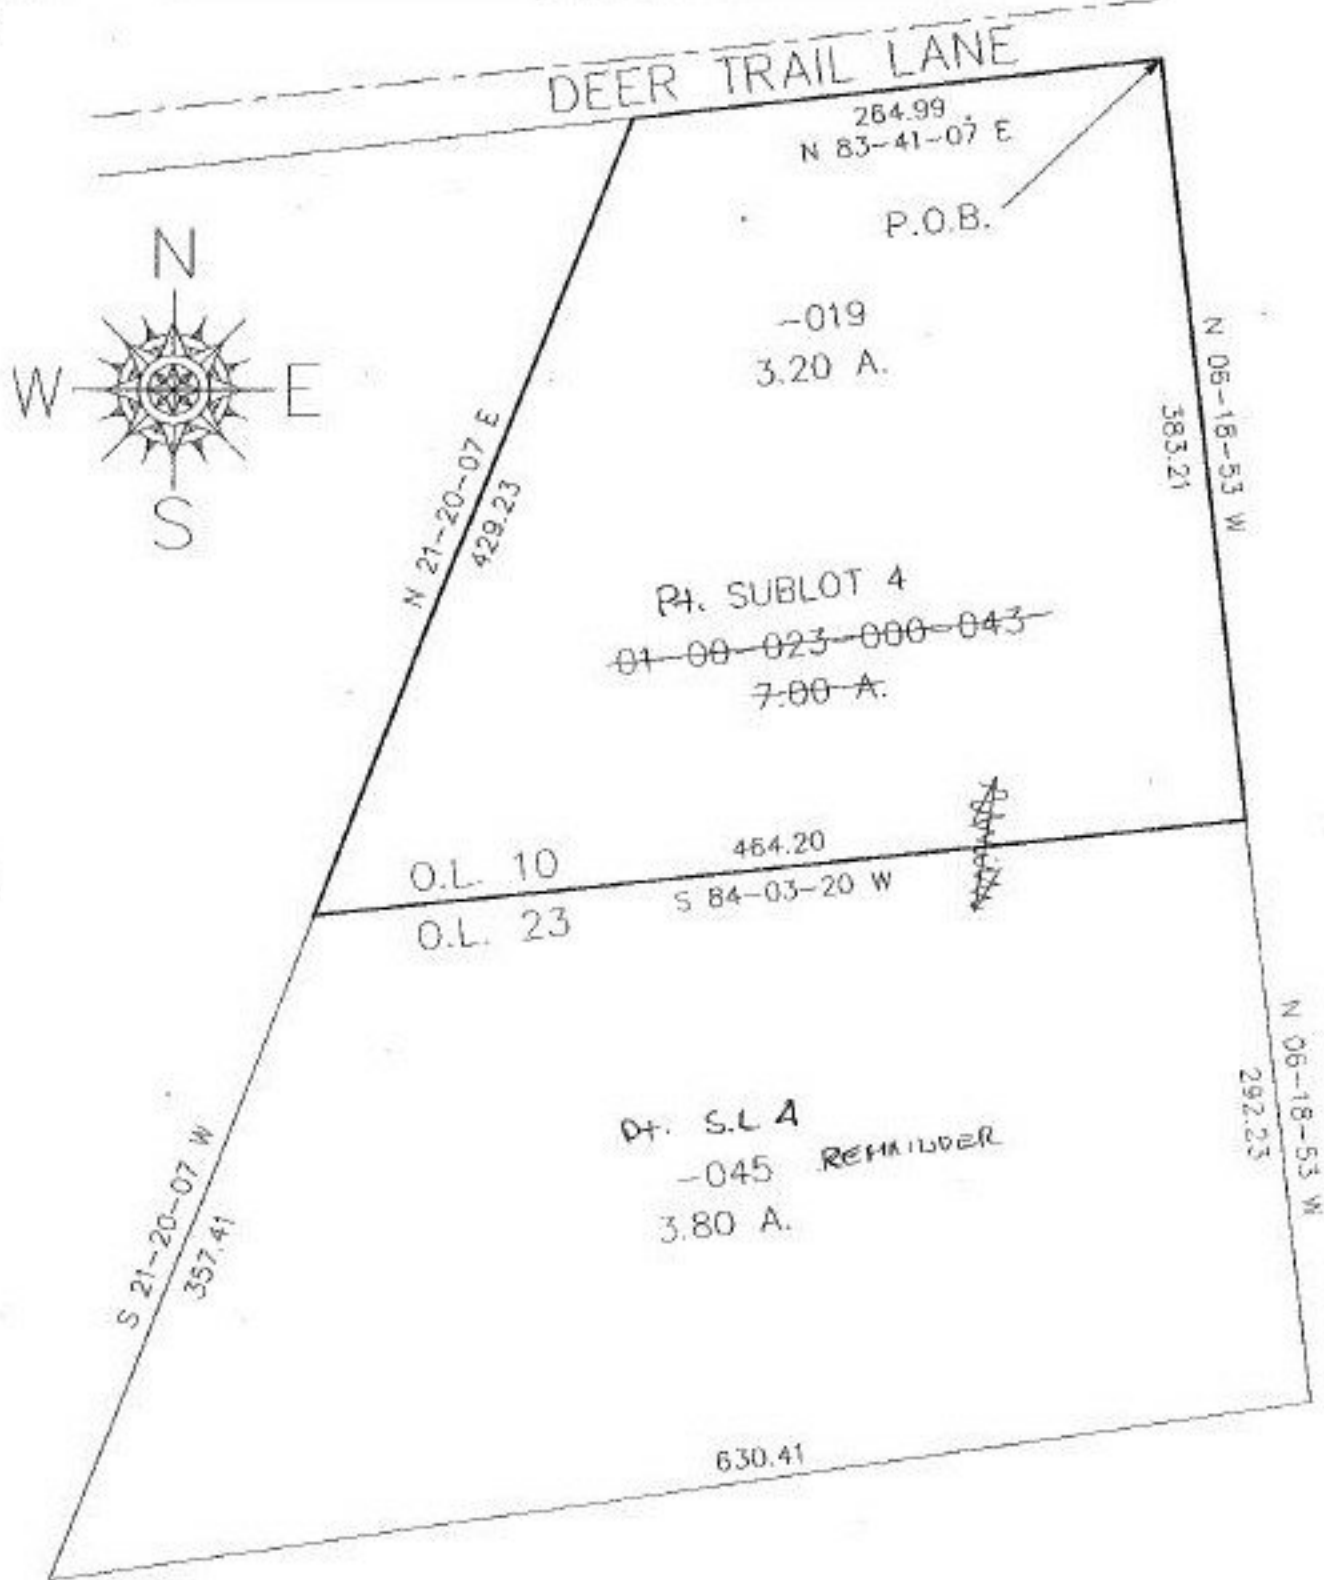

SPLITS/DEEDS PROCESSED
 LORAIN COUNTY TAX MAP DEPARTMENT
 226 MIDDLE AVE. ELYRIA, OHIO

SURVEYED BY: Richard A Rosebeck
 CLOSURE: 0.05 : 10,000
 MAP PAGE(S): 1-D & 1-H
 APPROVED BY: kac/REB DATE: 4/24/97
 SCALE: 1" = 100'