


#22146  
NO. 22146

PARENT PARCEL: 05-00-056-000-033

CHILD PARCEL: 05-00-056-000-054 & 055

STARTING POINT: cl. Old Middle Ridge Rd & n. line O.L. 56

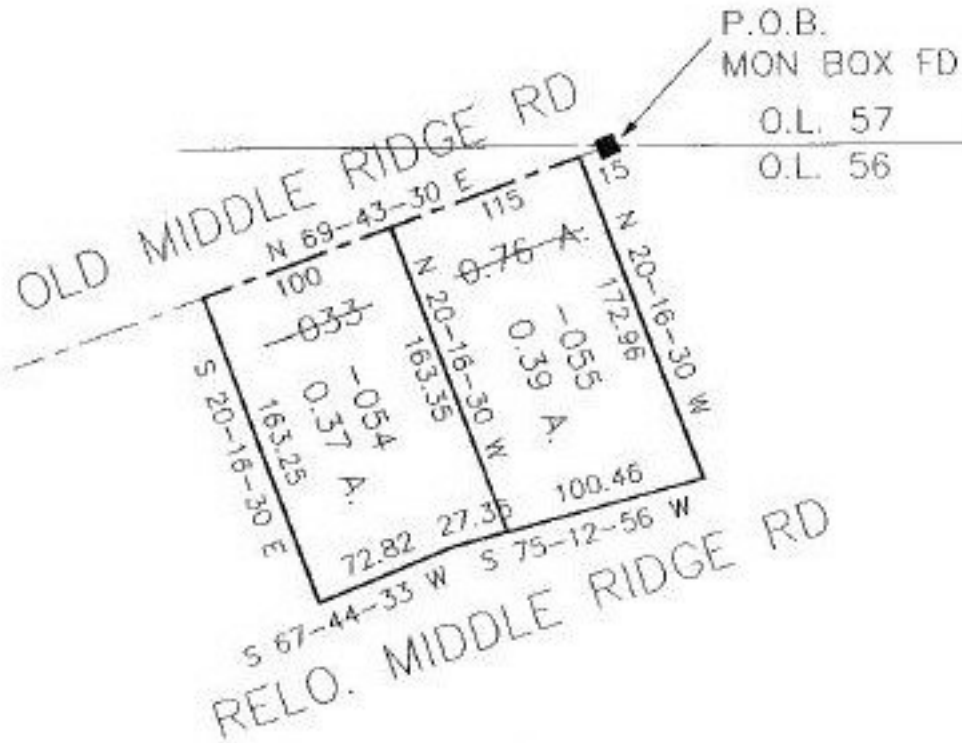

**SPLITS/DEEDS PROCESSED**  
LORAIN COUNTY TAX MAP DEPARTMENT  
226 MIDDLE AVE. ELYRIA, OHIO

SURVEYED BY: David L. Etwell  
CLOSURE: 0.05 per 10,000  
MAP PAGE(S): 05-00-056-A  
APPROVED BY: KAC/REB DATE: 4-22-97  
SCALE: 1" = 100'