
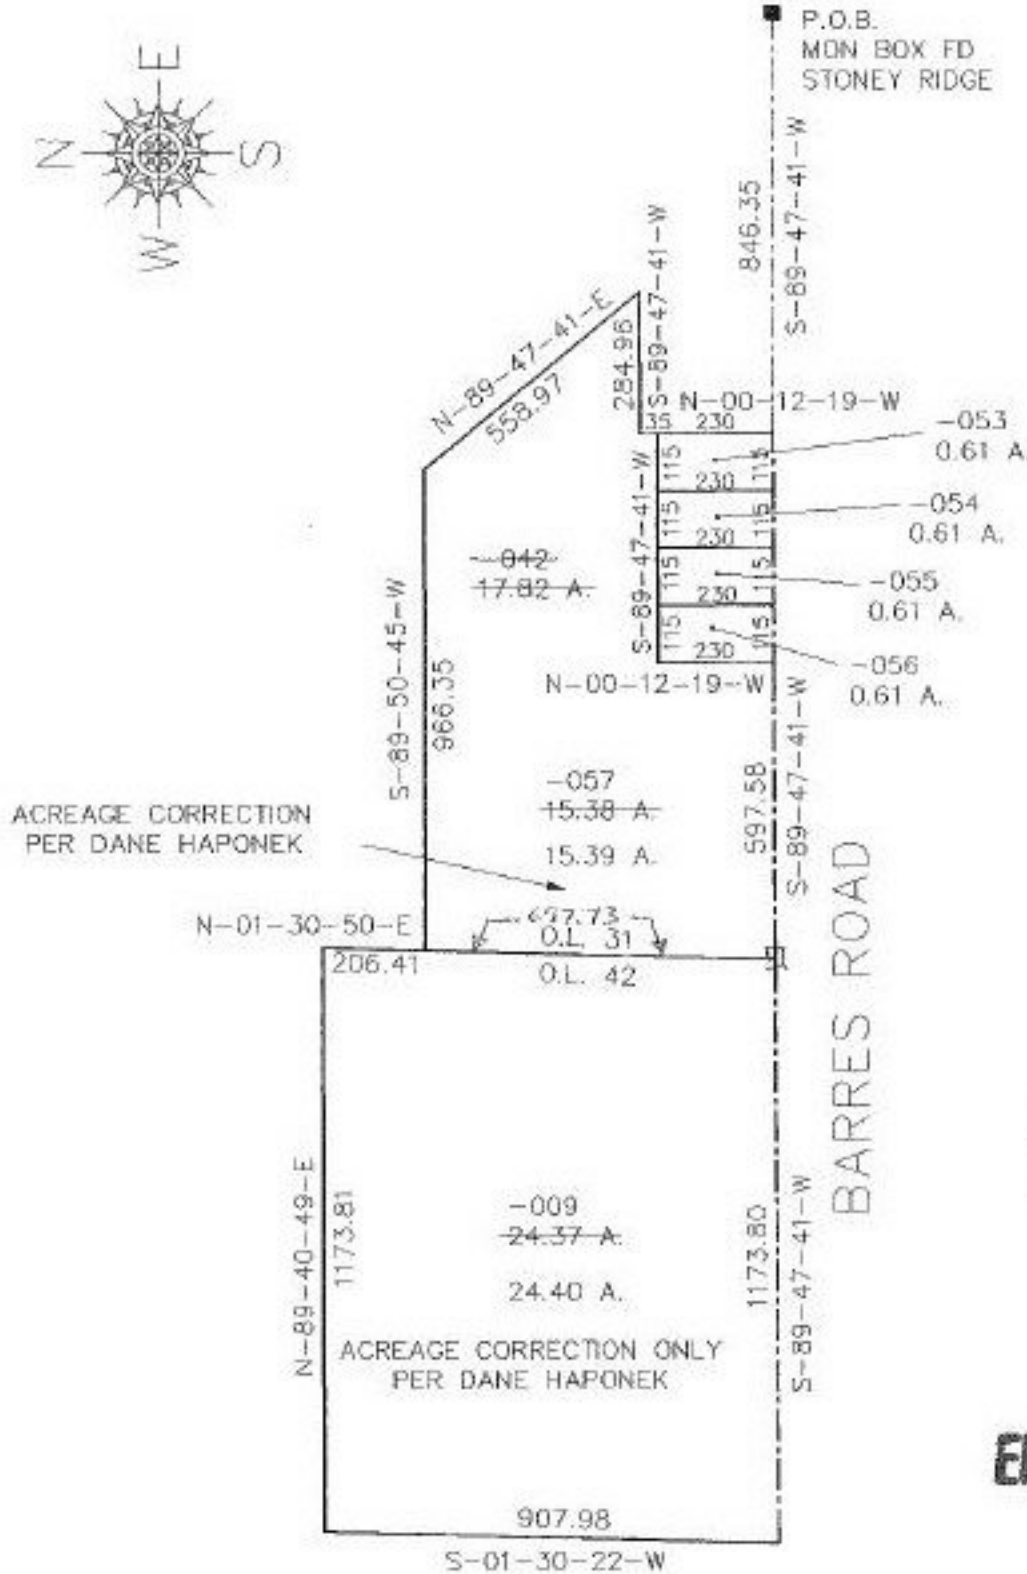


PARENT PARCEL: 07-00-031-000-042 & 07-00-042-000-009

CHILD PARCEL: 07-00-031-000-053 THRU -057

STARTING POINT: CL STONEY RIDGE RD. & CL BARRES RD.

NO. 22148

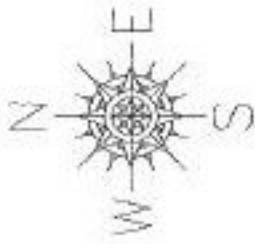

R. Beel
5/2/97

EFFECTIVE ACS
R 9-2-97



SPLITS/DEEDS PROCESSED
LORAIN COUNTY TAX MAP DEPARTMENT
226 MIDDLE AVE. ELYRIA, OHIO

SURVEYED BY: DANE A. HAPONEK
 CLOSURE: 0.00 PER 10,000
 MAP PAGE(S): 7-B 7-A+B
 APPROVED BY: KAC/RFB DATE: 4-11-97
 SCALE: 1" = 400'