


#22151  
NO. 22151

PARENT PARCEL: 12-00-054-000-038


CHILD PARCEL: 12-00-054-000-039, 040

STARTING POINT: CL OF COLUMBIA-WEST RIVER RD. & E. LINE O.L. 54

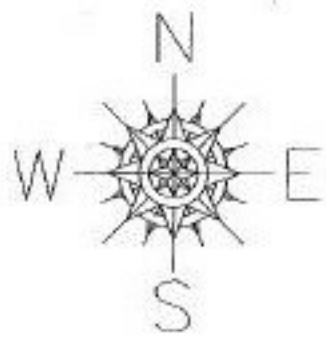

COLUMBIA-WEST RIVER RD

~~-038~~  
40.19 A.  
  
~~-040~~  
37.98 A.

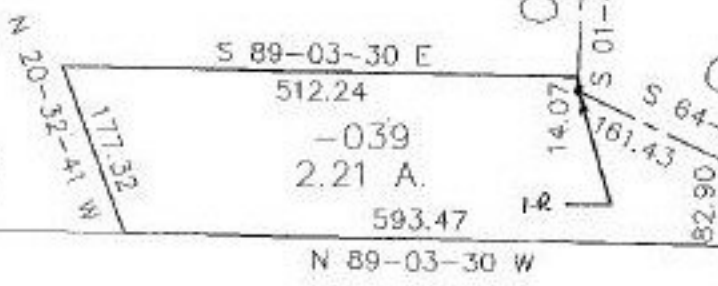

COLUMBIA-WEST RIVER RD

P.O.B

E. LINE O.L. 54



**SPLITS/DEEDS PROCESSED**  
LORAIN COUNTY TAX MAP DEPARTMENT  
226 MIDDLE AVE. ELYRIA, OHIO

SURVEYED BY:	JOHN G. HOY
CLOSURE:	0.02 PER 10,000
MAP PAGE(S):	12-00-054-A & B
APPROVED BY:	KAC/RFB DATE: 4-14-97
SCALE:	1" = 200'