



#22156
NO. 22156

PARENT PARCEL: 16-00-015-000-005, 16-00-026-000-006
CHILD PARCEL: 16-00-015-000-037 THRU 039
STARTING POINT: SE CORNER Q.L. 15

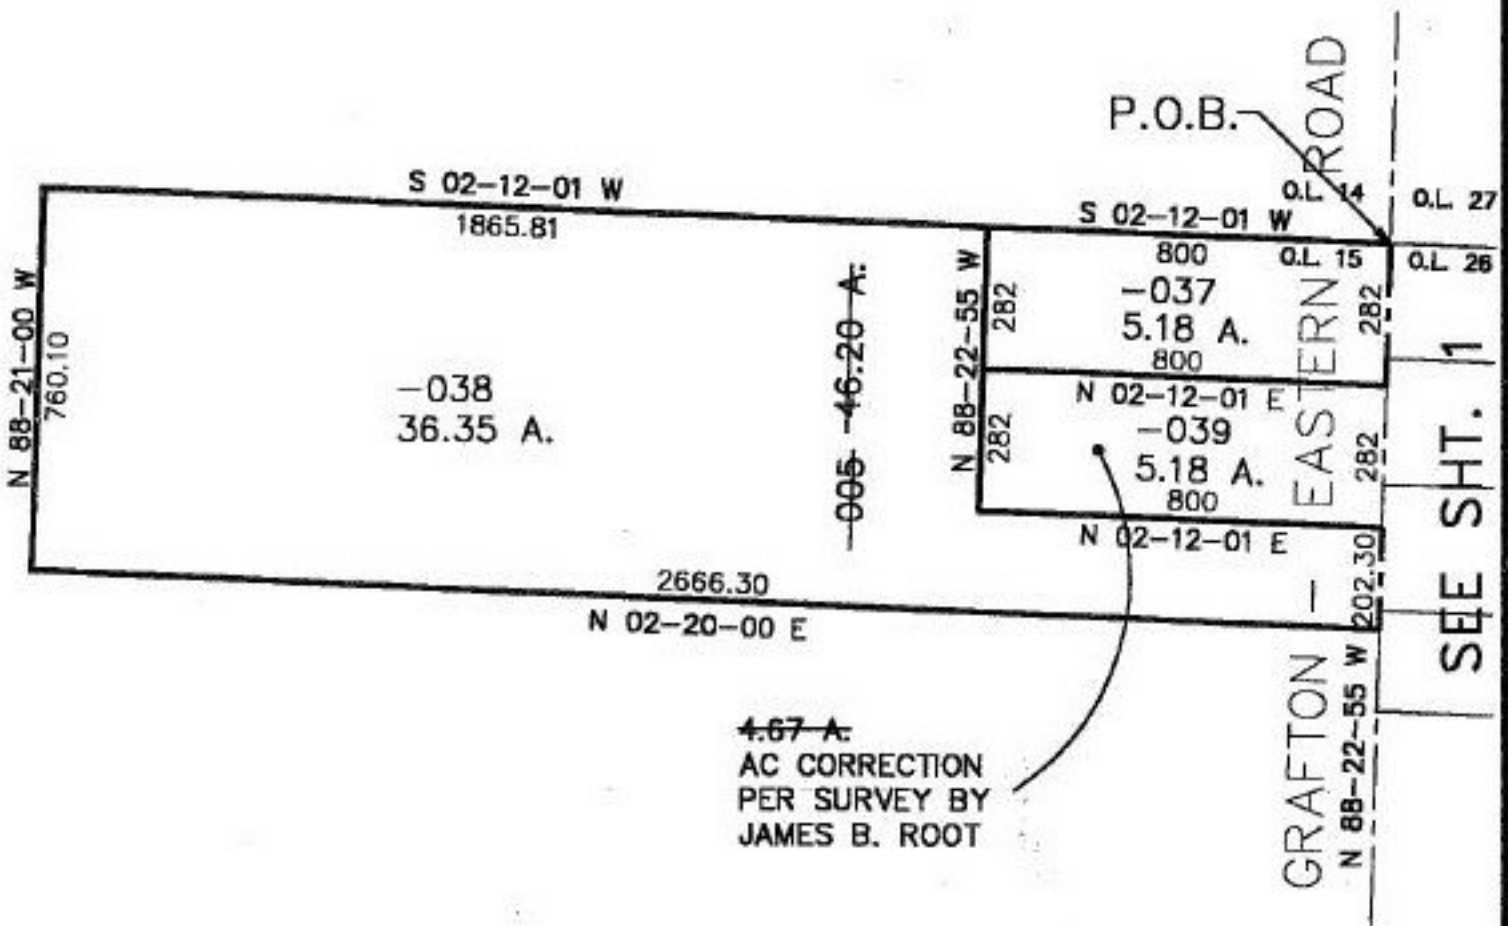

2 OF 2

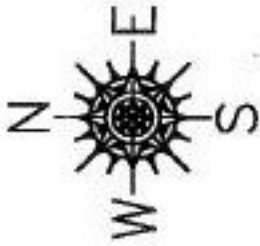

SPLITS/DEEDS PROCESSED
LORAIN COUNTY TAX MAP DEPARTMENT
226 MIDDLE AVE. ELYRIA, OHIO

SURVEYED BY: JAMES B. ROOT
CLOSURE: 0.00 : 10.000
MAP PAGE(S): 16-00-015 B
APPROVED BY: KAC/REB DATE: 4/30/97
SCALE: 1" = 400'