


#22160

NO. 22160

PARENT PARCEL: 04-00-023-102-009

CHILD PARCEL: 04-00-023-102-027, 028

STARTING POINT: cl. of Jaycox Rd. & cl. of Keller St.

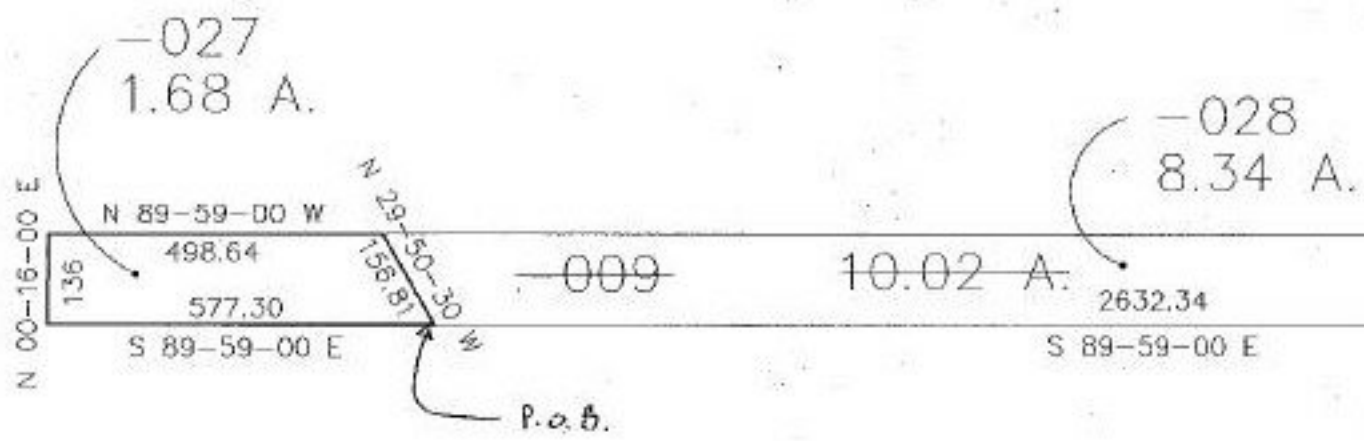

see sheet 1 of 2



**SPLITS/DEEDS PROCESSED**  
 LORAIN COUNTY TAX MAP DEPARTMENT  
 226 MIDDLE AVE. ELYRIA, OHIO

SURVEYED BY: James J. Kroll  
 CLOSURE: 0.00  
 MAP PAGE(S): 04-00-023-A, B, 04-00-014-D  
 APPROVED BY: kac/REB DATE: 5/27/97  
 SCALE: 1" = 300'