

PARENT PARCEL: 09-00-001-102-065, 09-00-002-000-004, 005, 006, 043


CHILD PARCEL: n/a

STARTING POINT: CL. QUARRY ROAD DISTANT 767.20' NLY FROM S. LINE O.L. 2

No. 22162-D



ACREAGE CORR.
PER SURVEY BY
CHARLES P. WARYU

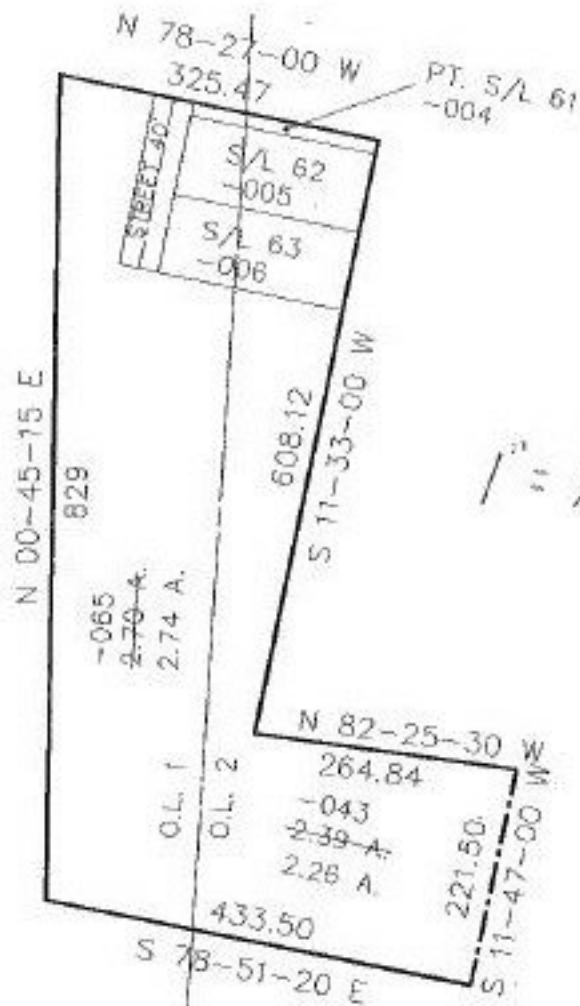

DETAIL
SCALE 1" = 200'

TOTAL AC. O.L. 2 = 2.74 A.
-0.21 A. pt. s/l 63 (pt.-006)
-0.23 A. pt. s/l 62 (pt.-005)
-0.04 A. pt. s/l 61 (pt.-004)
2.26 A. (-043)

TOTAL AC. O.L. 1 = 3.18 A.
-0.14 A. pt. s/l 63 (pt.-006)
-0.12 A. pt. s/l 62 (pt.-005)
-0.02 A. pt. s/l 61 (pt.-004)
-0.16 A. pt. s/l 61 (pt.-004)
2.74 A. (-065)

S. LINE O.L. 2

EFFECTIVE 9/30/97
AW



SPLITS/DEEDS PROCESSED
LORAIN COUNTY TAX MAP DEPARTMENT
226 MIDDLE AVE. ELYRIA, OHIO

SURVEYED BY: CHARLES P. WARYU
CLOSURE: 0.01 : 10.000
MAP PAGE(S): 09-00-002A & 09-00-001B
APPROVED BY: RFB DATE: 04/18/97
SCALE: 1" = 400'