
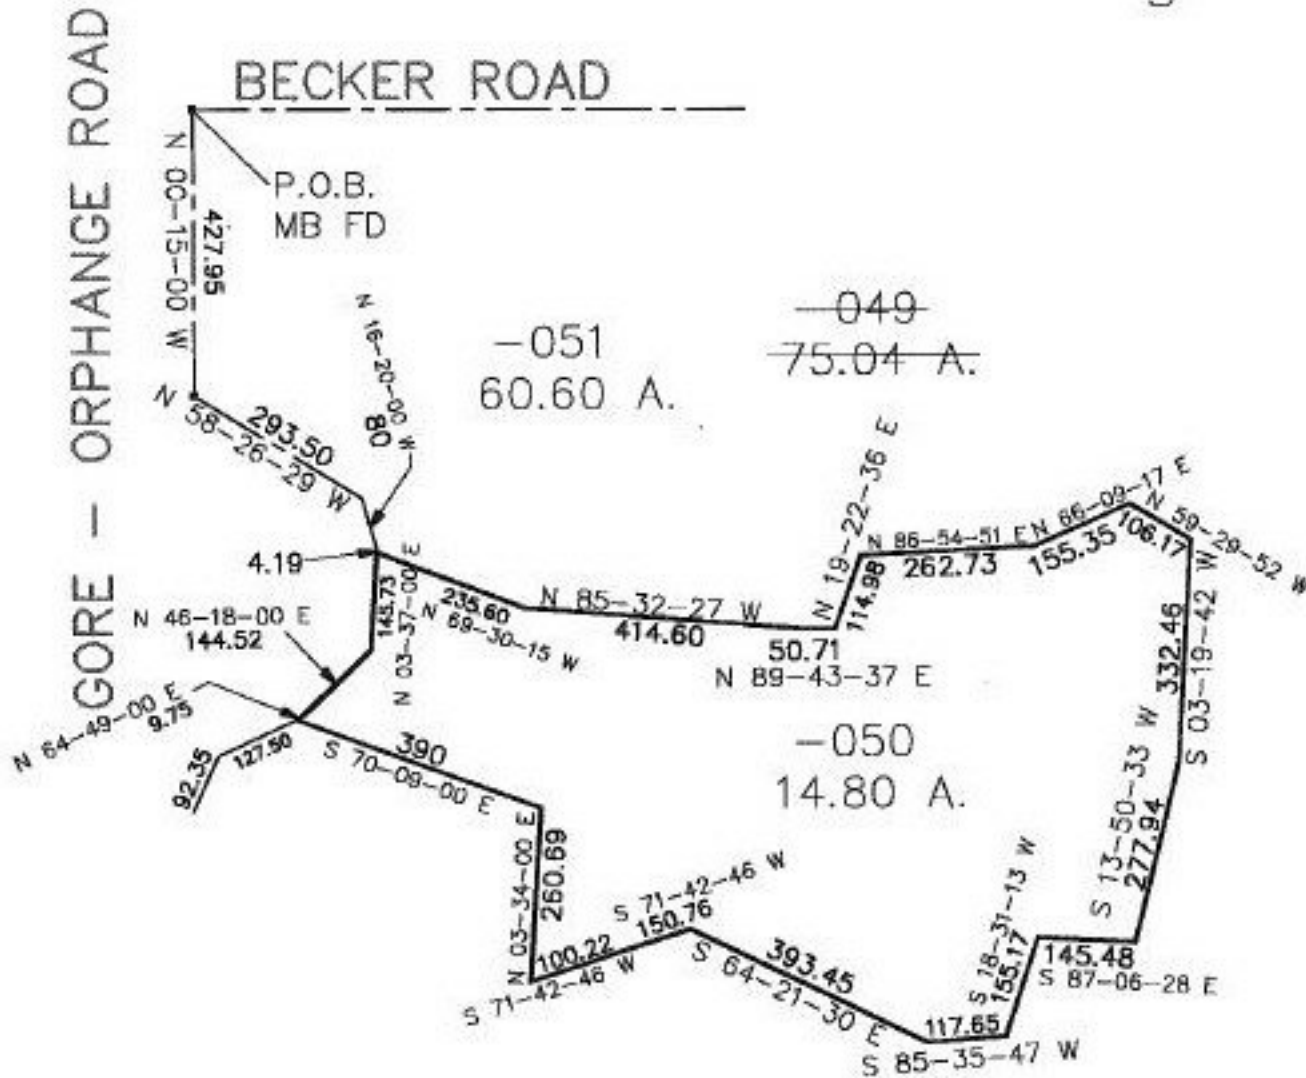


PARENT PARCEL: 08-12-012-000-049

CHILD PARCEL: 08-12-012-000-050, 051

STARTING POINT: MB FD AT INT CL BECKER RD & GORE-ORPHANAGE RD

NO. 22162

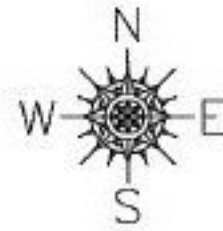

EFFECTIVE ACS  
R 10-15-97

JS  
2-18-98



SPLITS/DEEDS PROCESSED  
LORAIN COUNTY TAX MAP DEPARTMENT  
226 MIDDLE AVE. ELYRIA, OHIO

SURVEYED BY: PATRICK A. MCGANNON  
CLOSURE: 0.02 : 10.000  
MAP PAGE(S): B-F  
APPROVED BY: REF DATE: 5/8/97  
SCALE: 1" = 300'