

#22163

PARENT PARCEL: 04-00-001-103-135



CHILD PARCEL: 04-00-001-103-166, 167

STARTING POINT: North-east corner of Camelot Subdivision No. 2

NO. 22163



P.O.B

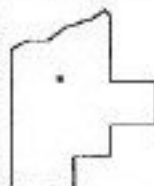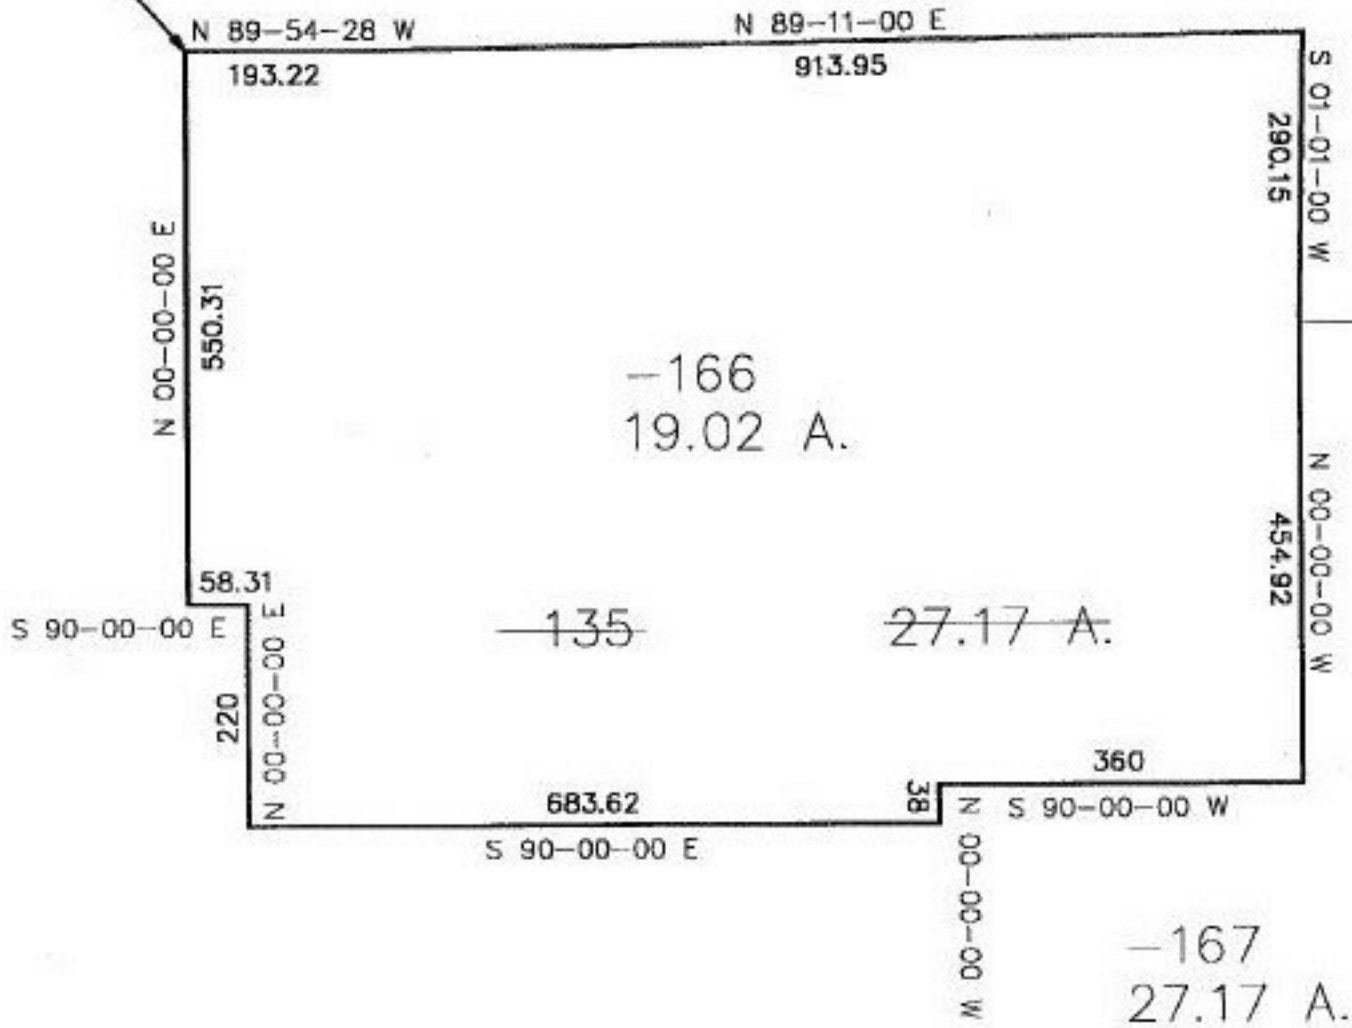

SPLITS/DEEDS PROCESSED
LORAIN COUNTY TAX MAP DEPARTMENT
226 MIDDLE AVE. ELYRIA, OHIO

0.00 per 10,000 Ehtesham M. Suhail

CLOSURE: 0.00 ; 10,000

MAP PAGE(S): 4-1

APPROVED BY: kac/RFB DATE: 4/30/97

SCALE: 1"=200