

#22164

NO. 22164

PARENT PARCEL: 19-03-054-000-013, 19-03-055-000-035
CHILD PARCEL: 19-03-054-000-017, 018 & 19-03-055-000-036, 037, 038
STARTING POINT: CL OF FOSTER RD & CL STATE ROUTE 18 (NE LINE OL 55)


MEDINA - NORWALK RD (SR 18)



P.O.B.
IP FD

FOSTER ROAD
60'

R/S

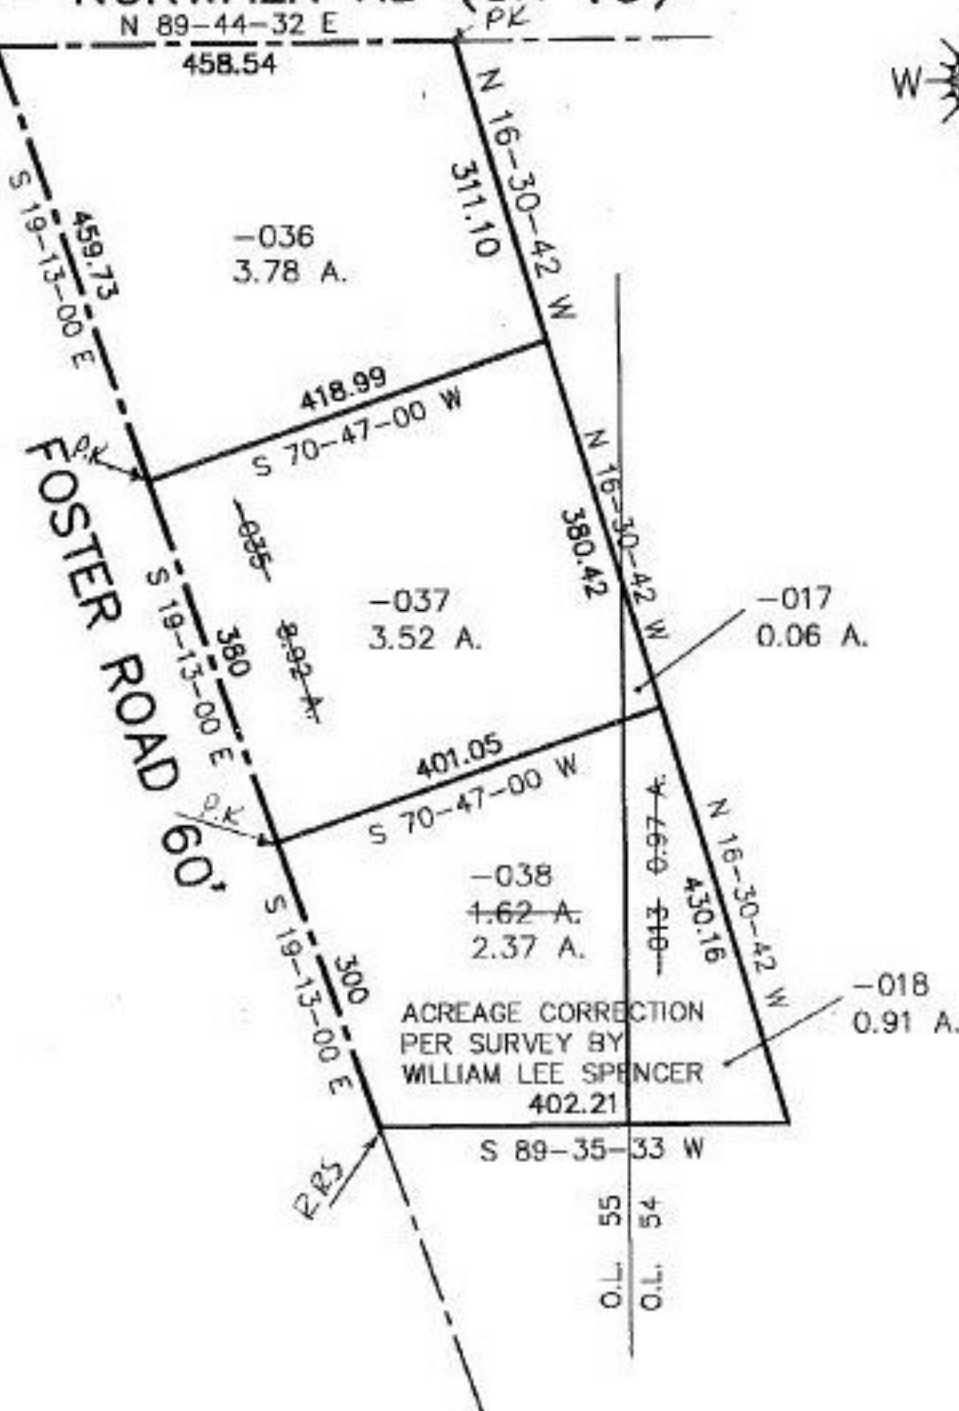

SPLITS/DEEDS PROCESSED
LORAIN COUNTY TAX MAP DEPARTMENT
226 MIDDLE AVE. ELYRIA, OHIO

SURVEYED BY: WILLIAM LEE SPENCER
CLOSURE: 0.09 : 10,000
MAP PAGE(S): 19-H
APPROVED BY: REB DATE: 05/08/97
SCALE: 1"=200