


PARENT PARCEL: 06-24-006-000-042

CHILD PARCEL: 06-24-006-000-046 & 047


STARTING POINT: c.l. of Murray Ridge Rd. & n. line of O.L. 6

NO. 22167

EFFECTIVE 6/20/97

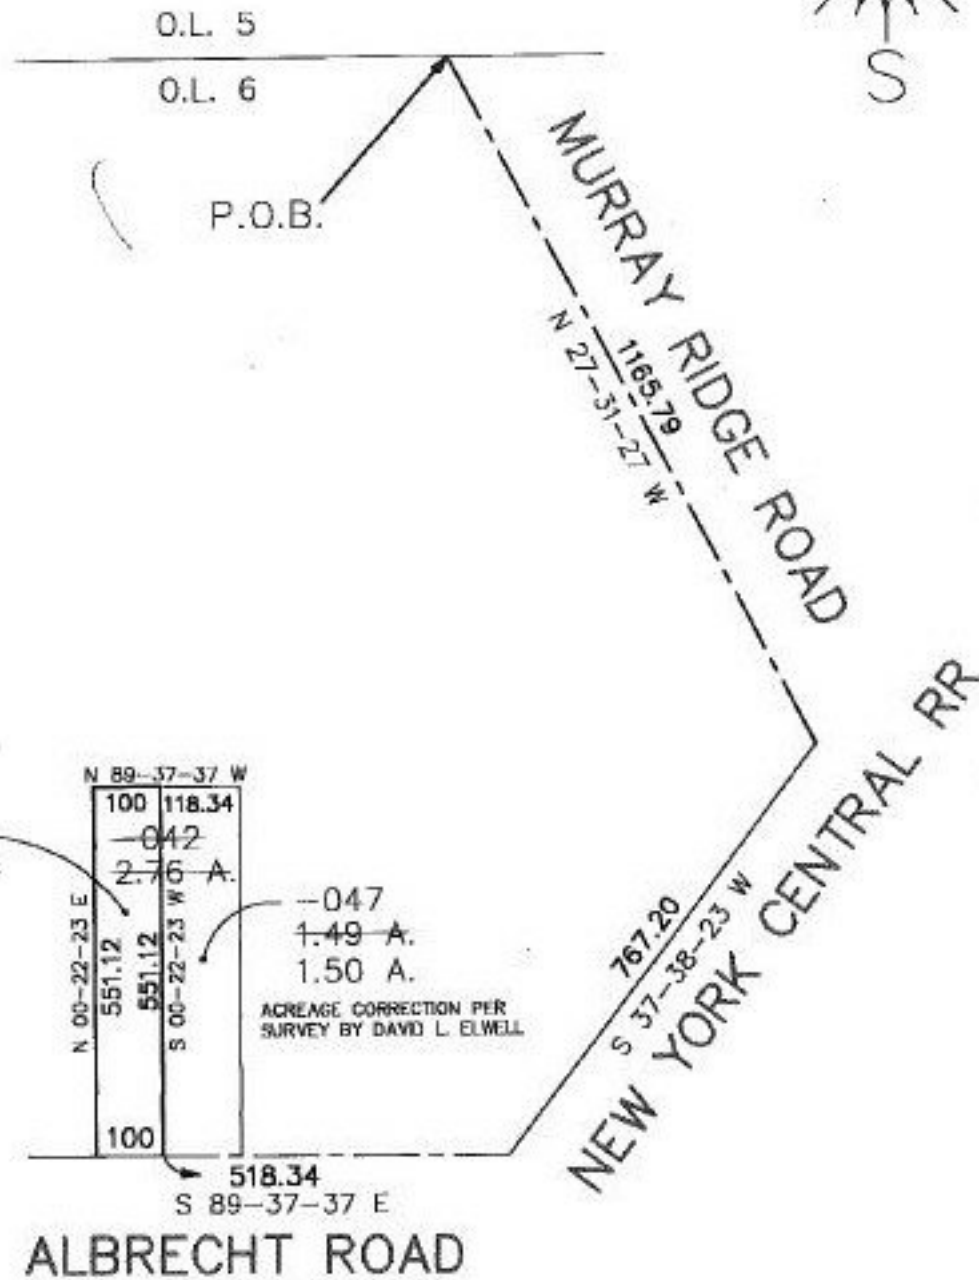

ACREAGE CORRECTION PER SURVEY BY DAVID L. ELWELL

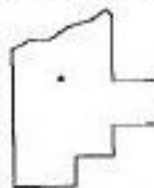

SPLITS/DEEDS PROCESSED  
LORAIN COUNTY TAX MAP DEPARTMENT  
226 MIDDLE AVE. ELYRIA, OHIO

SURVEYED BY: David L. Elwell  
CLOSURE: 0.00 per 10,000  
MAP PAGE(S): 06-130  
APPROVED BY: kac/RFB DATE: 5/13/97  
SCALE: 1" = 300'

JAYLAR CR 11-9-98 761