


#22170

NO. 22170

PARENT PARCEL: 16-00-012-000-024

CHILD PARCEL: 16-00-012-000-028, 029, 030 & 031

STARTING POINT: se corner of O.L. 12

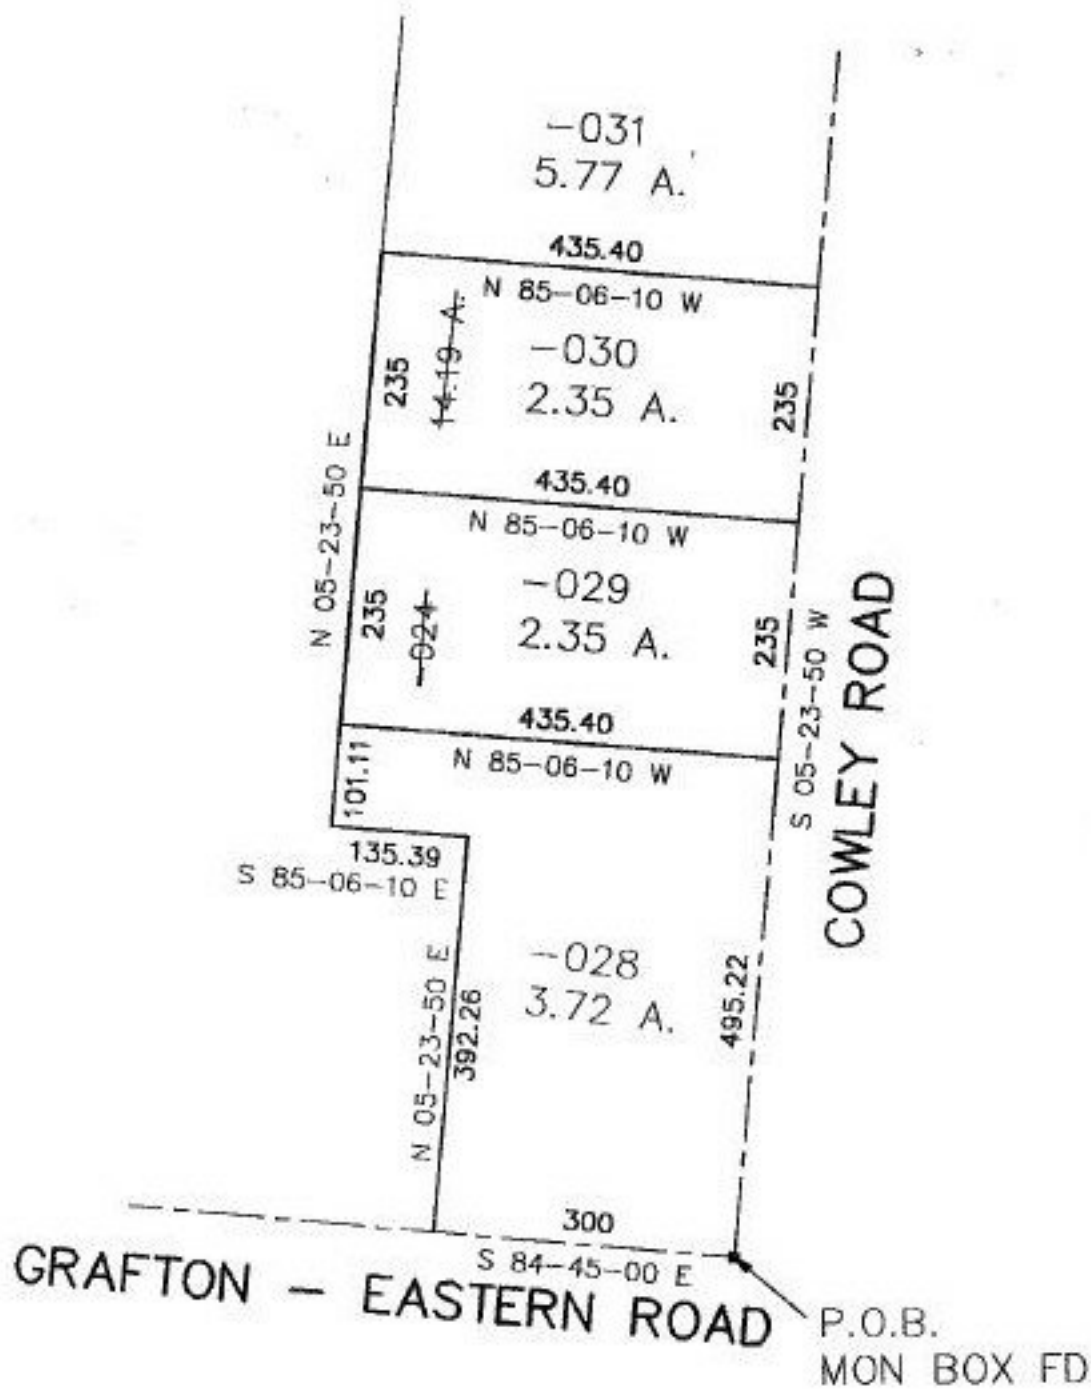

SPLITS/DEEDS PROCESSED

LORAIN COUNTY TAX MAP DEPARTMENT
226 MIDDLE AVE. ELYRIA, OHIO

SURVEYED BY: James B. Roberts

CLOSURE: 0.02 per 10,000

MAP PAGE(S): 16-0

APPROVED BY: kac/RFB DATE: 5/13/97

SCALE: 1"=200