


LEGAL DESCRIBES 10-00-01-1000-110-1
#22175 (-163)
(-123)

"UPDATE LEGAL"

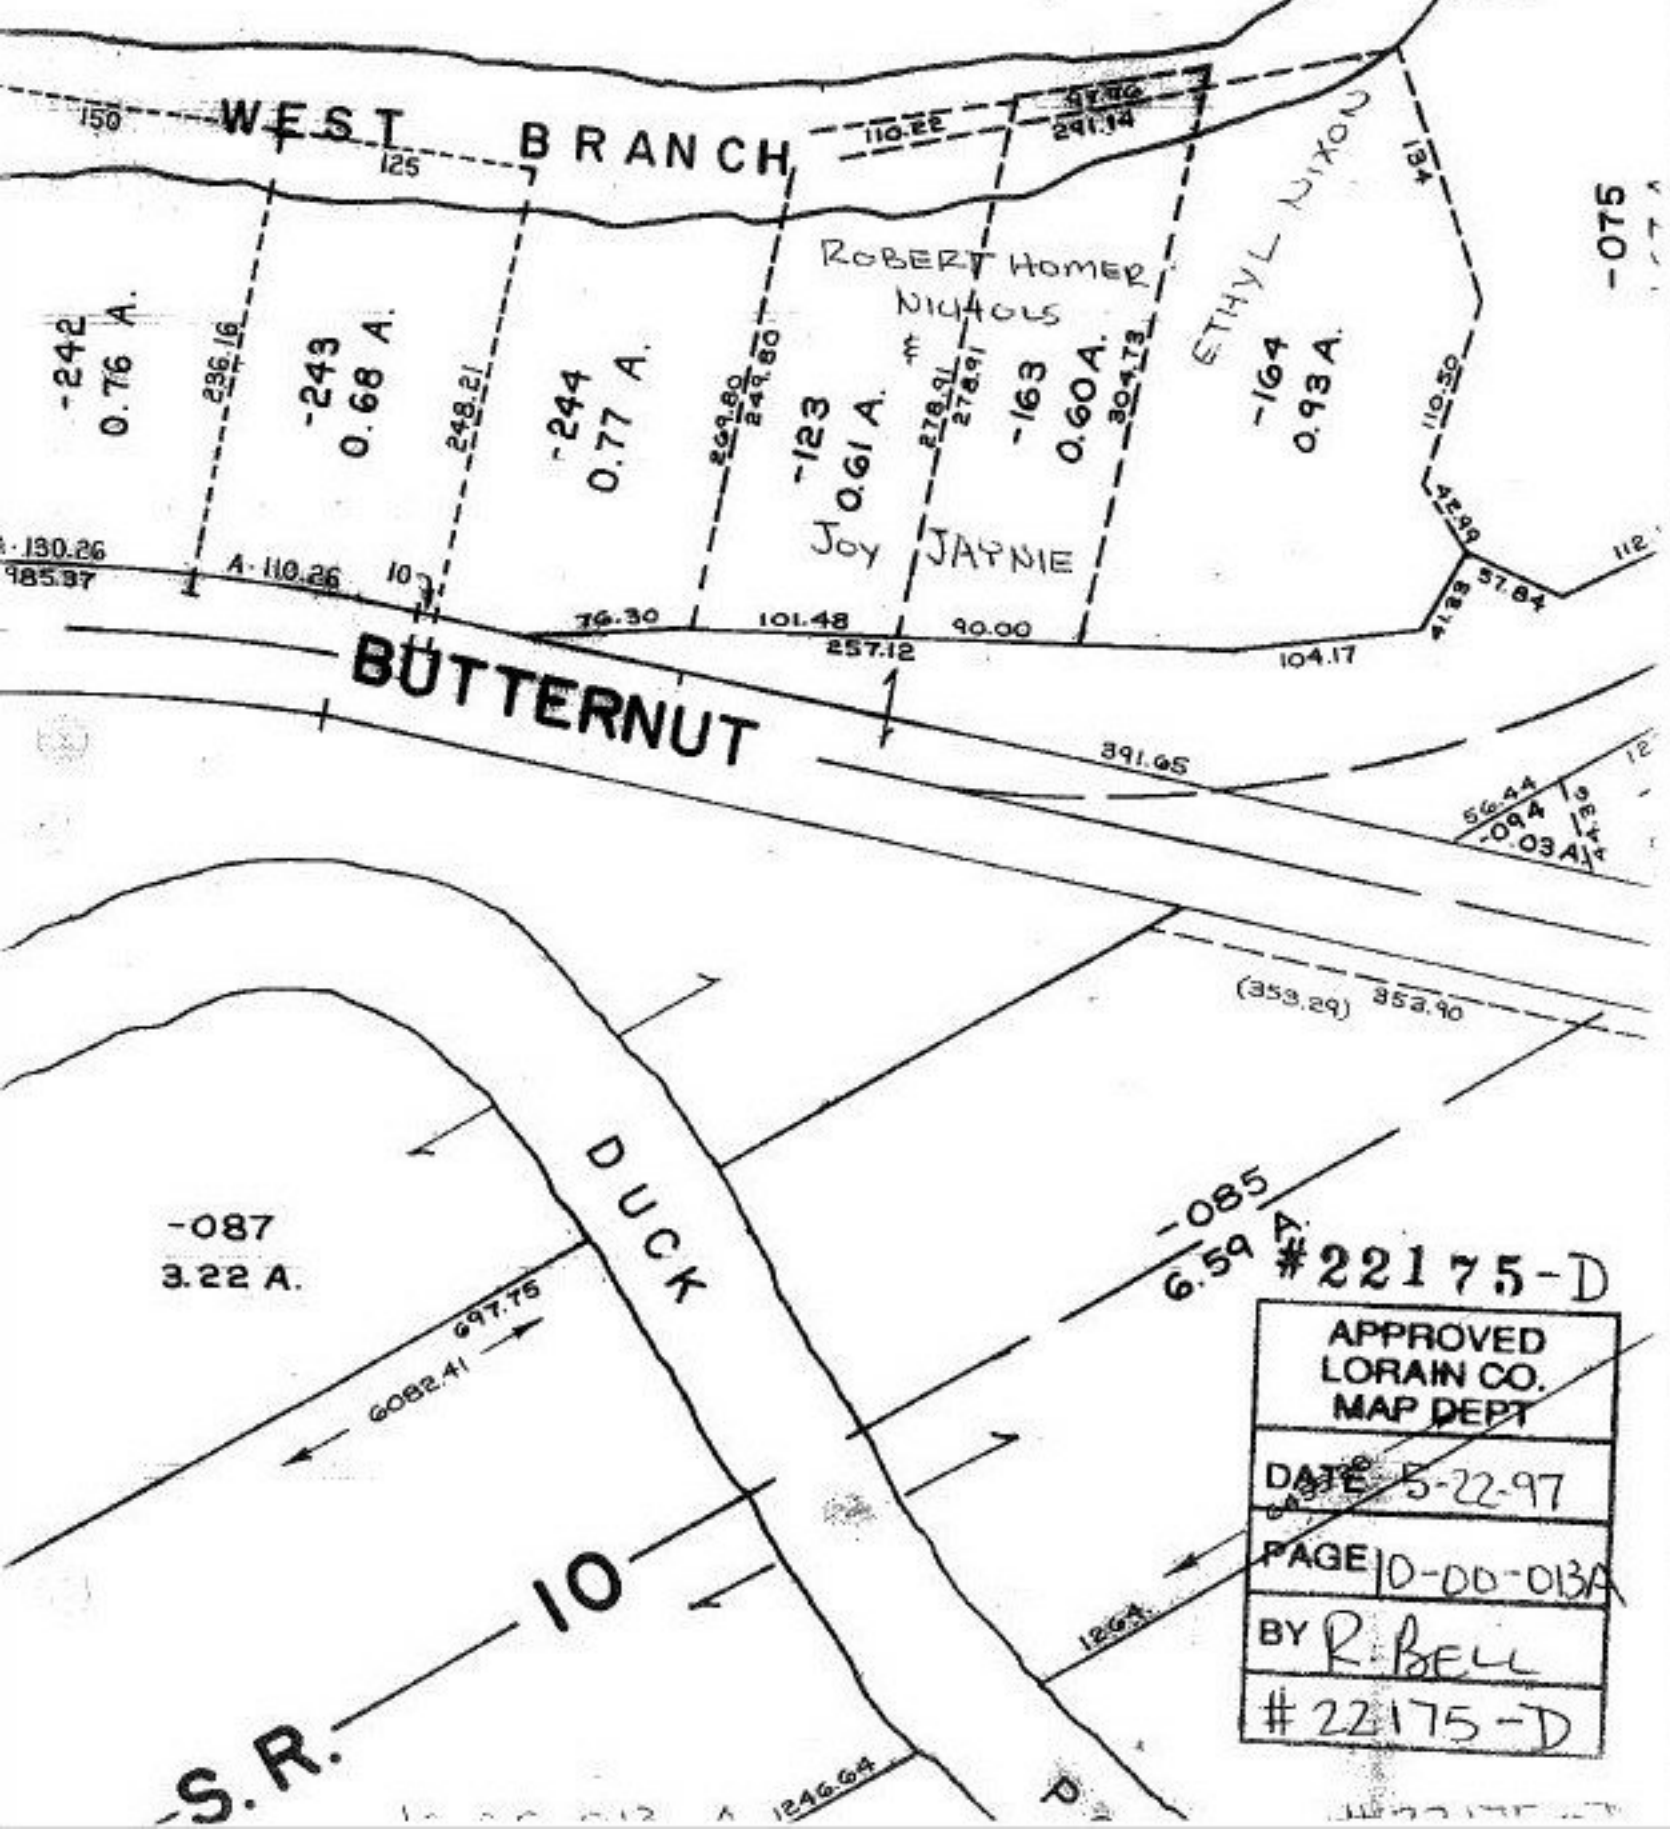

-085
6.59 A. #22175-D

APPROVED LORAIN CO. MAP DEPT
DATE 5-22-97
PAGE 10-00-013A
BY R. BELL
#22175-D