


PARENT PARCEL: 05-00-053-000-022, 05-00-052-000-015, 05-00-069-000-001

CHILD PARCEL: n/a

STARTING POINT: INT CL OBERLIN RD & SLY LINE O.L. 52

NO. 22176

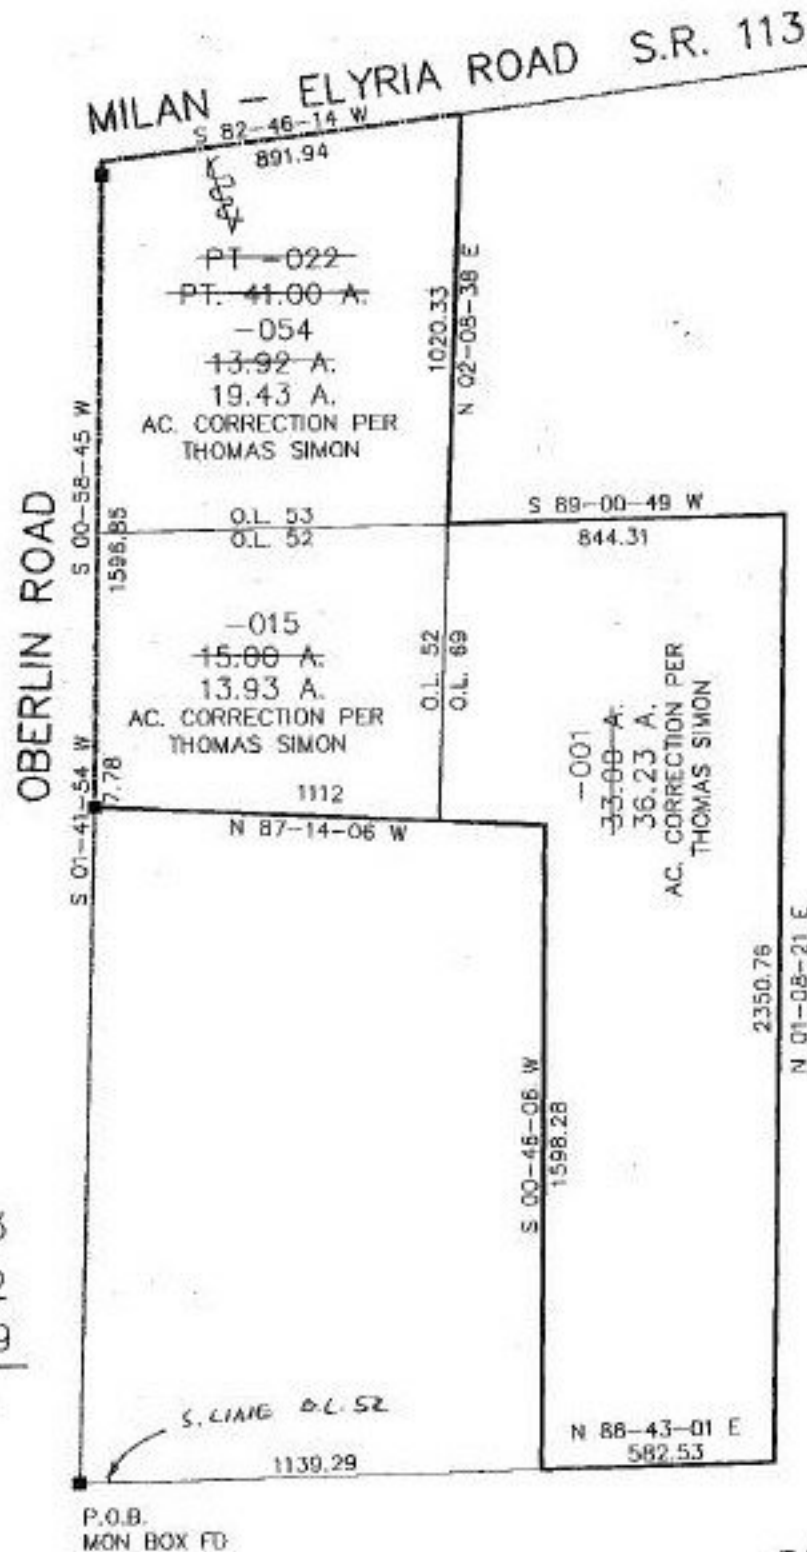

19.43 A. O.L. 53  
 13.93 A. O.L. 52  
 36.23 A. O.L. 69  
 -----  
 69.59 A. TOTAL

SHEET 2 OF 2



**SPLITS/DEEDS PROCESSED**  
 LORAIN COUNTY TAX MAP DEPARTMENT  
 226 MIDDLE AVE. ELYRIA, OHIO

SURVEYED BY: THOMAS A. SIMON  
 CLOSURE: 0.01 : 10,000  
 MAP PAGE(S): 5-H, 5-00-053B, 5-00-052B  
 APPROVED BY: REB DATE: 06/12/97  
 SCALE: 1" = 500'