
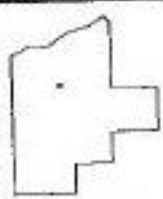


#22177

NO. 22177

PARENT PARCEL: 16-00-009-000-009, 010, 011, 012
 CHILD PARCEL: 16-00-009-000-020, 021, 022
 STARTING POINT: Southeast corner of O.L. 9

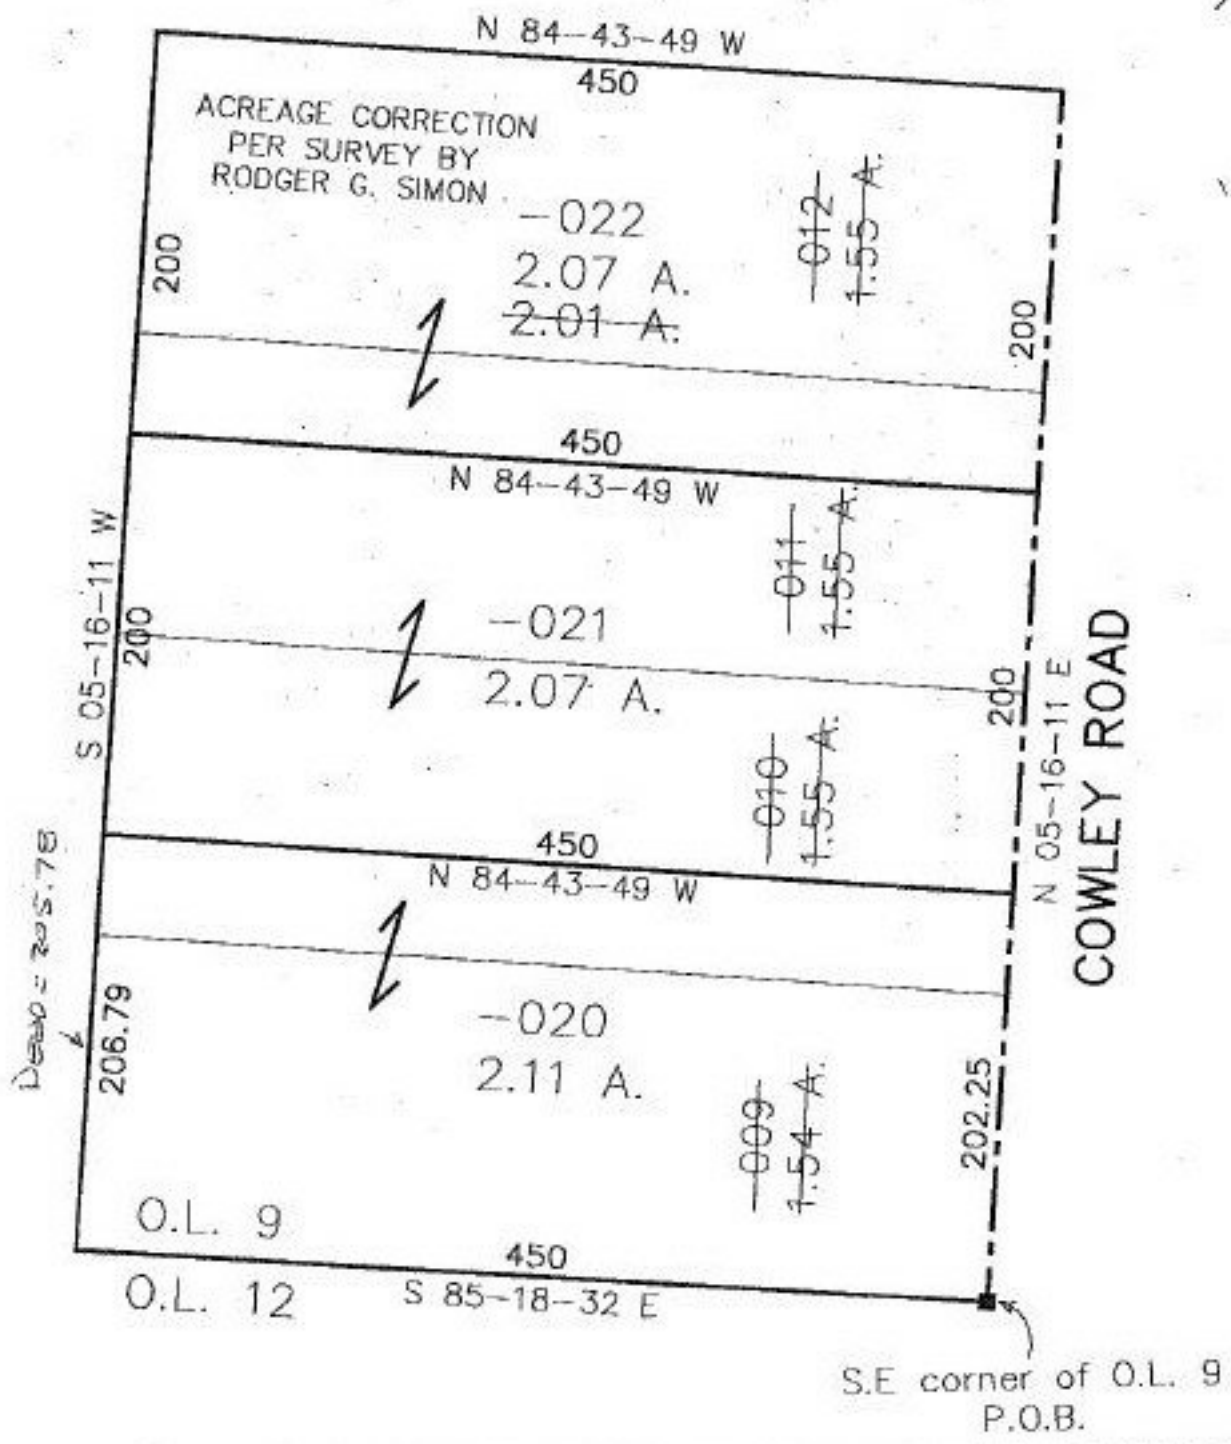

SPLITS/DEEDS PROCESSED
 LORAIN COUNTY TAX MAP DEPARTMENT
 226 MIDDLE AVE. ELYRIA, OHIO

SURVEYED BY: Rodger G. Simon
 CLOSURE: 0.18 per 10,000
 MAP PAGE(S): 16-D
 APPROVED BY: kac/REB DATE: 5/19/97
 SCALE: 1" = 100'