


#22183

NO. 22183

PARENT PARCEL: 01-00-056-000-032, 006, 031
CHILD PARCEL: 01-00-056-000-037, 038, 039
STARTING POINT: cl. of Middle Ridge Rd. & w. line of O.L. 56



P.O.B
IP FD

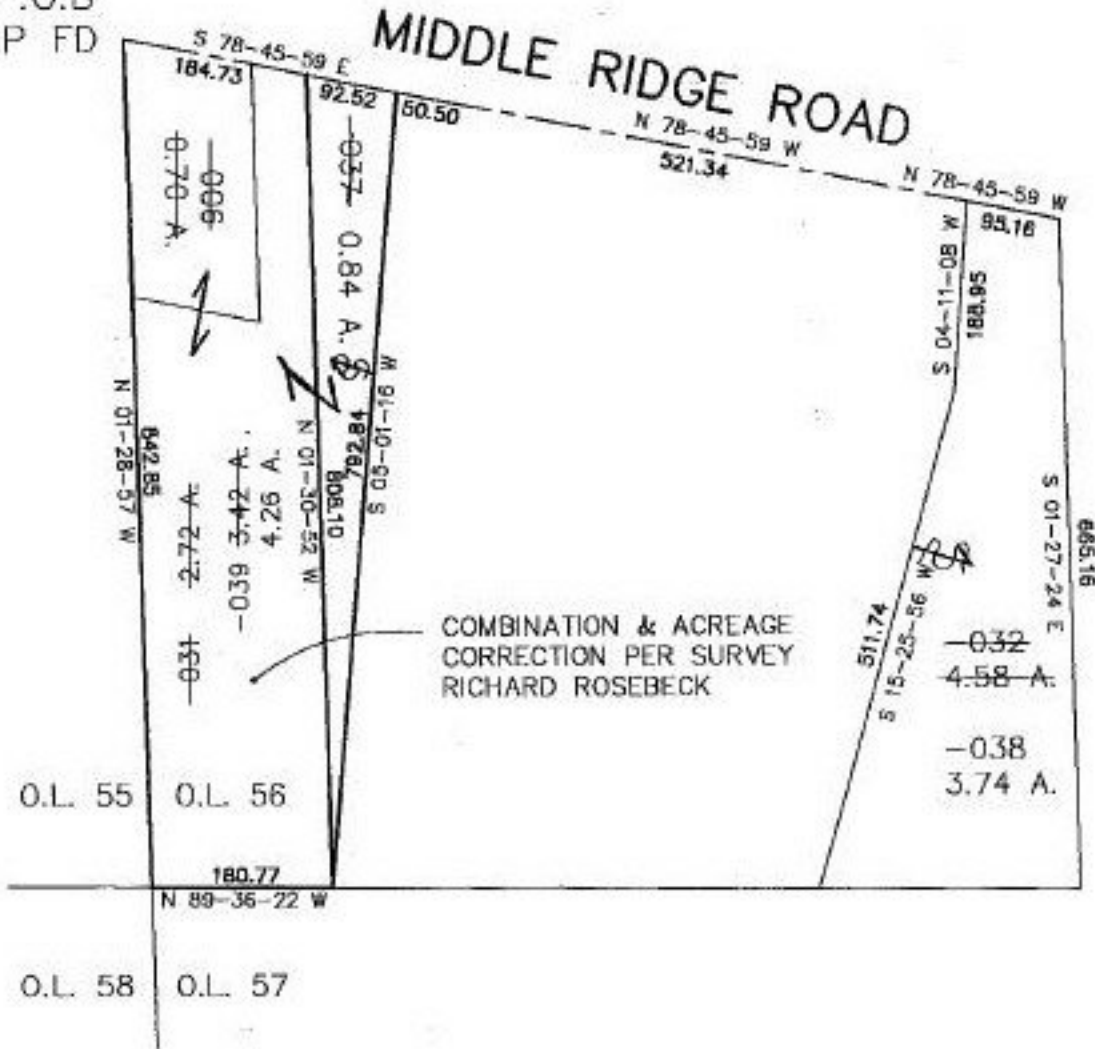

SPLITS/DEEDS PROCESSED
LORAIN COUNTY TAX MAP DEPARTMENT
226 MIDDLE AVE. ELYRIA, OHIO

SURVEYED BY: Richard Rosebeck
CLOSURE: 0.12 per 10.000
MAP PAGE(S): 1-L
APPROVED BY: kac/REB DATE: 05-15-97
SCALE: 1"=200