


#22189

NO. 22189

PARENT PARCEL: 05-00-065-000-033
CHILD PARCEL: 05-00-065-000-036 THRU 039
STARTING POINT: INT CL OBERLIN ROAD & CL STANG ROAD

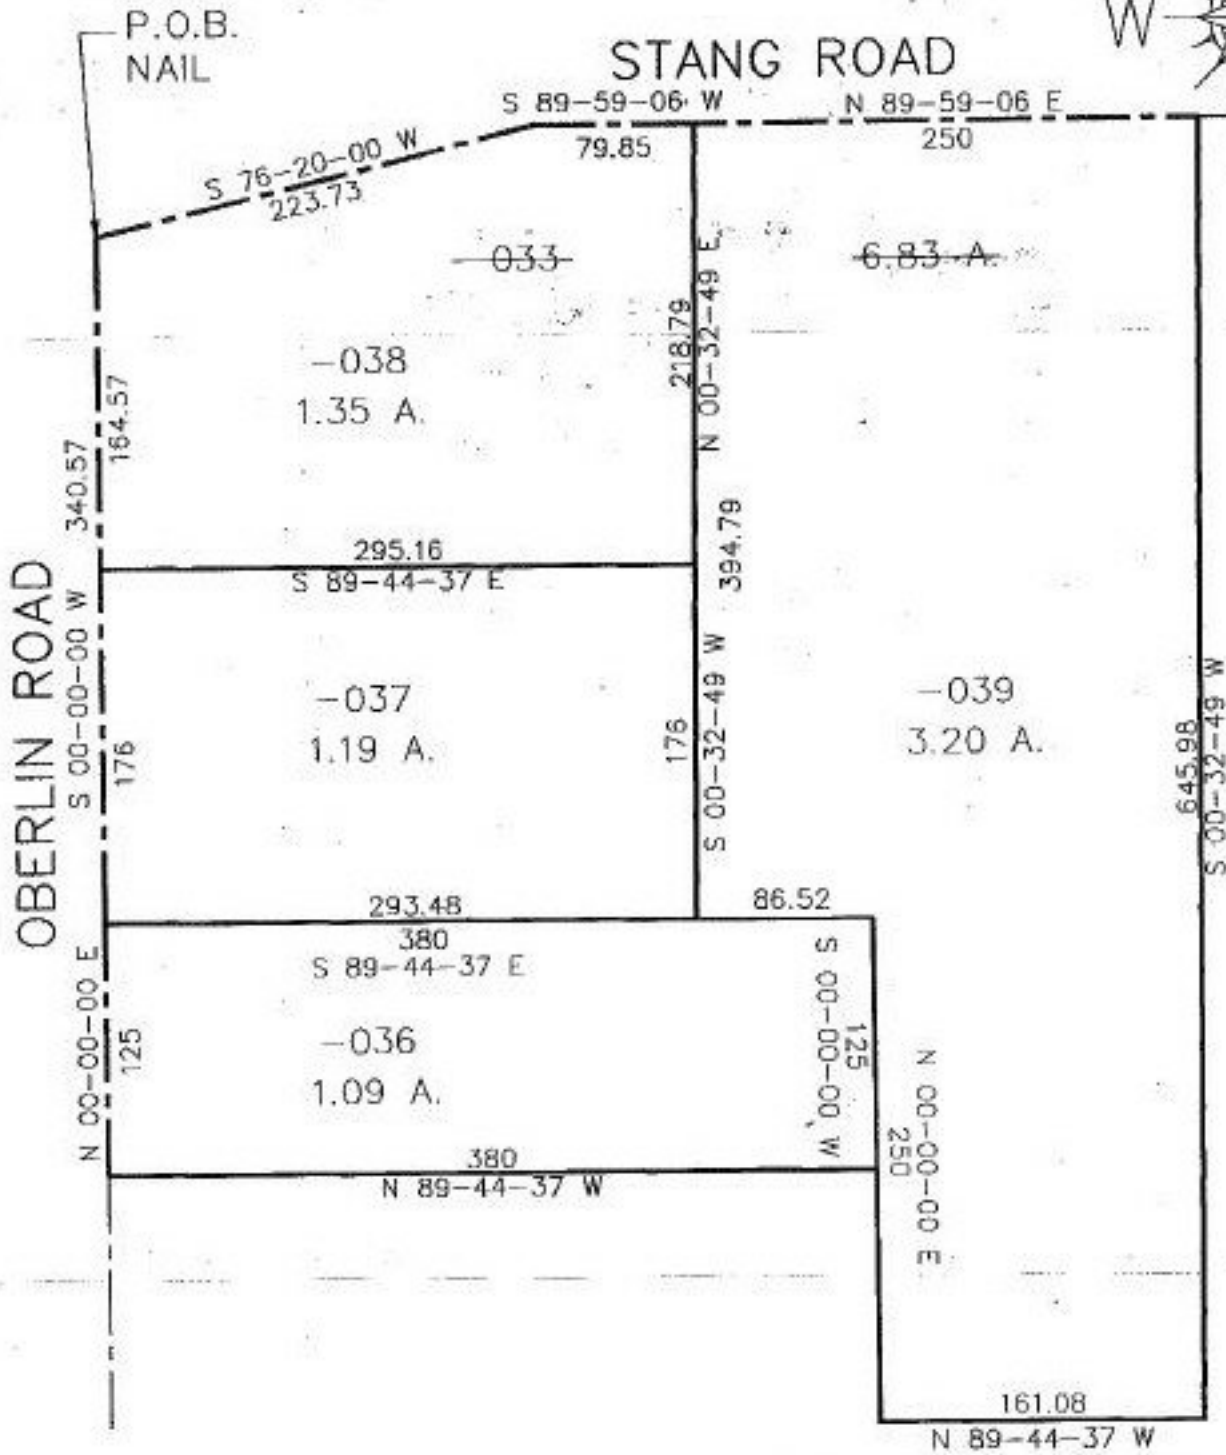

SPLITS/DEEDS PROCESSED
LORAIN COUNTY TAX MAP DEPARTMENT
226 MIDDLE AVE. ELYRIA, OHIO

SURVEYED BY: CHARLES P. WARYU
CLOSURE: 0.07 : 10,000
MAP PAGE(S): 5-0
APPROVED BY: RFB DATE: 06/06/97
SCALE: 1" = 100'