


#22190

Rocky

SEE 12-00-040-B

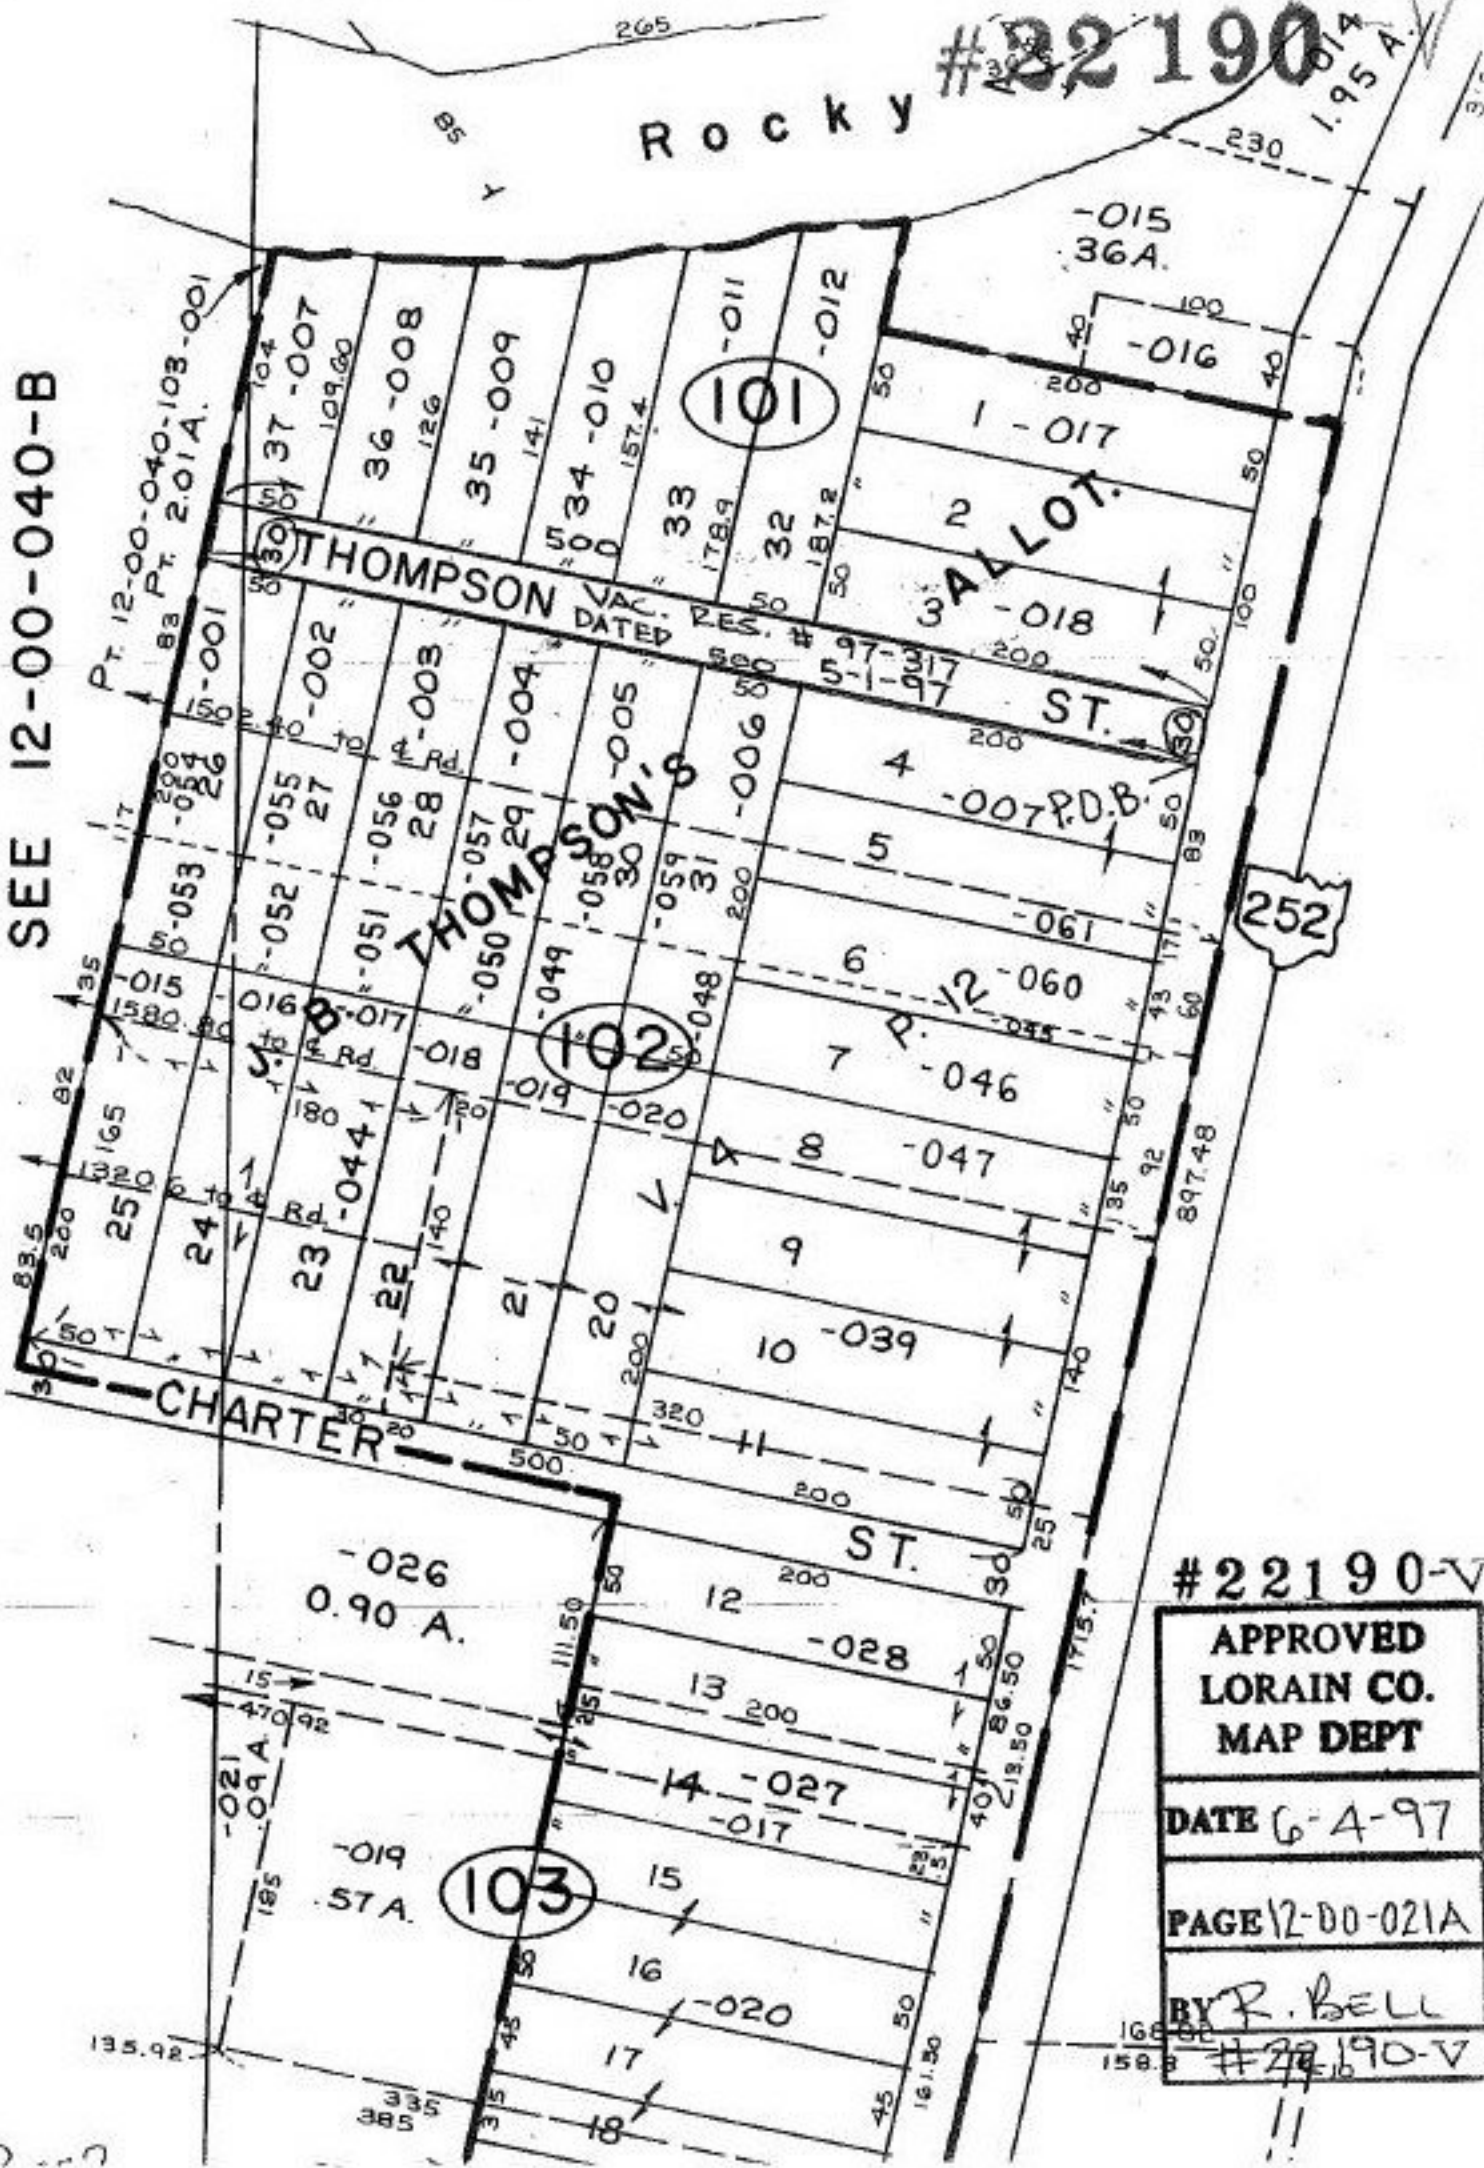

#22190-V

APPROVED
LORAIN CO.
MAP DEPT

DATE 6-4-97

PAGE 12-00-021A

BY R. BELL

#22190-V

!!