
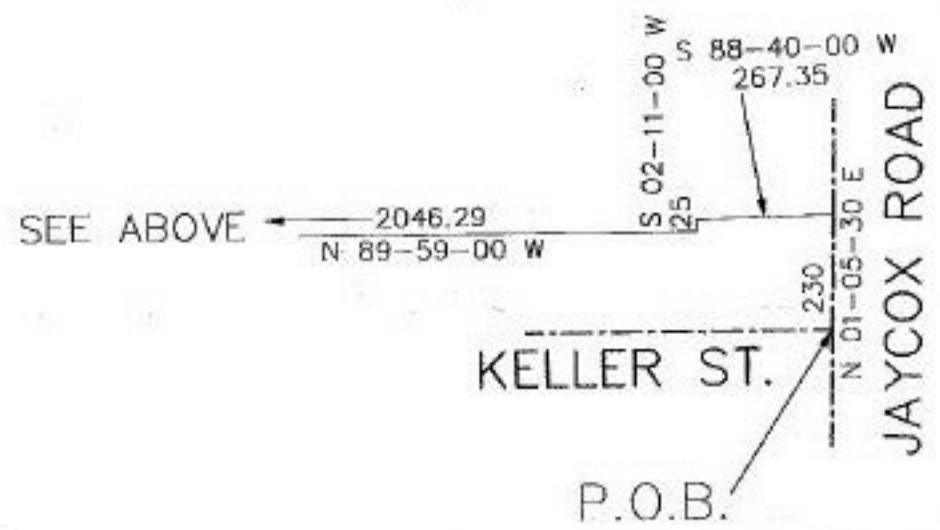


#22190

PARENT PARCEL: 04-00-023-102-026
CHILD PARCEL: 04-00-023-102-029 & 030
STARTING POINT: INT CL KELLER ST & CL JAYCOX RD

NO. 22190

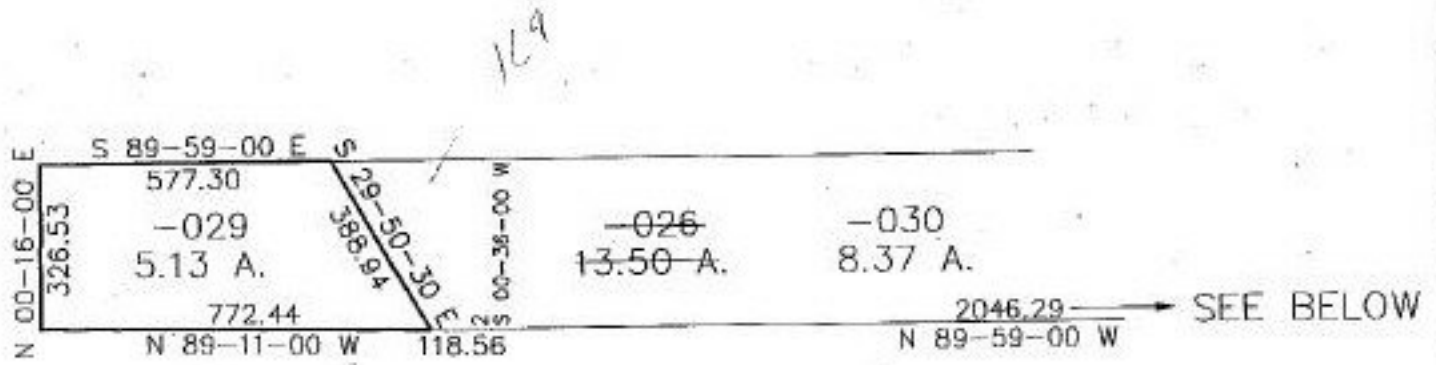

SPLITS/DEEDS PROCESSED
LORAIN COUNTY TAX MAP DEPARTMENT
226 MIDDLE AVE. ELYRIA, OHIO

SURVEYED BY: JAMES J. KRALL
CLOSURE: 0.02 : 10,000
MAP PAGE(S): 4-00-023 B
APPROVED BY: RFB DATE: 06/09/97
SCALE: 1" = 400