


#22195

NO. 22195

PARENT PARCEL: 12-00-014-000-006
CHILD PARCEL: 12-00-014-000-007, 008, 009
STARTING POINT: cl of Boone Rd. & s. line of O.L. 14

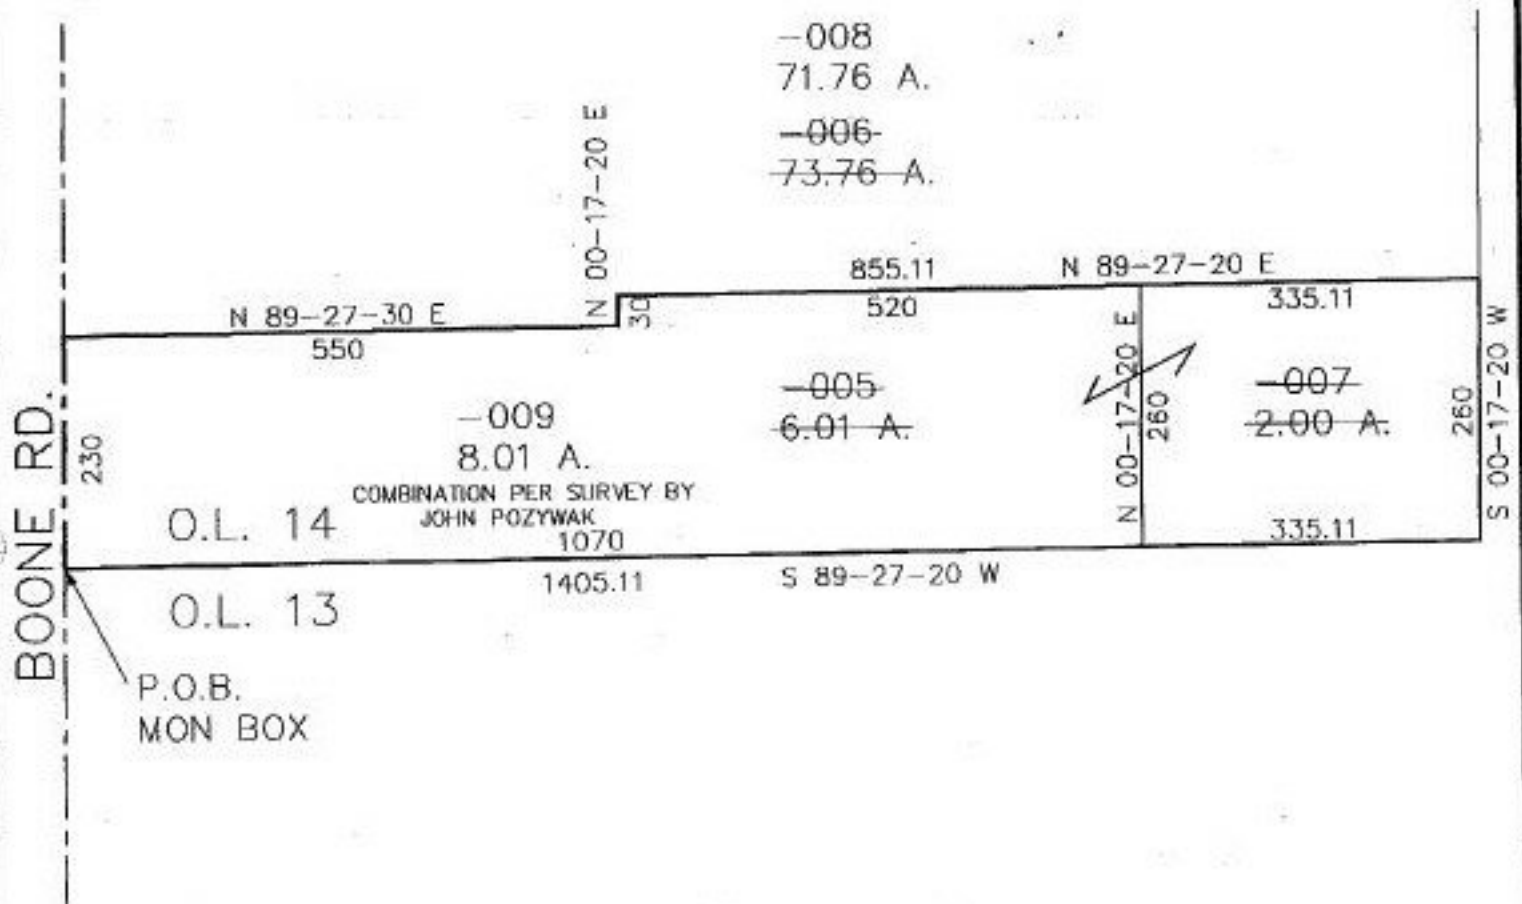

SPLITS/DEEDS PROCESSED
LORAIN COUNTY TAX MAP DEPARTMENT
226 MIDDLE AVE. ELYRIA, OHIO

SURVEYED BY: JOHN POZYWAK
CLOSURE: 0.08 PER 10,000
MAP PAGE(S): 12-00-014-A
APPROVED BY: KAC/BFB DATE: 5/27/97
SCALE: 1"=200