

PARENT PARCEL: 04-00-017-103-119
CHILD PARCEL: 04-00-017-103-214 & 215
STARTING POINT: MB @ INT CL WALKER RD & AVON BELDEN RD


NO. 22197



P.O.B.
MB FD

WALKER ROAD

AVON-BELDEN RD SR 83

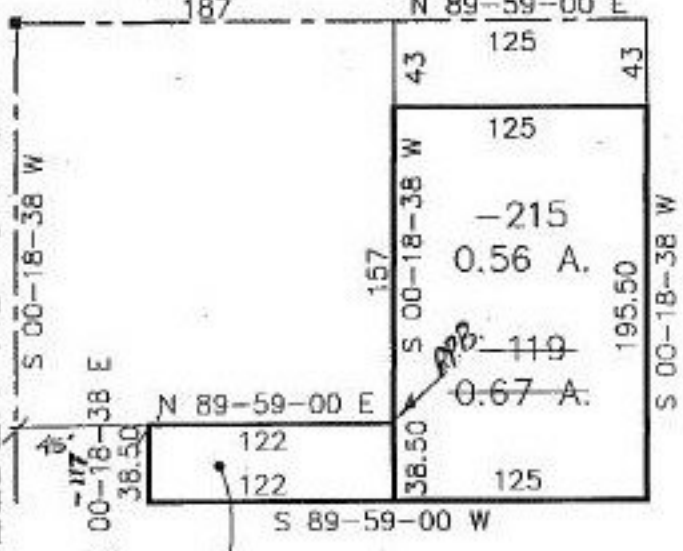

SPLITS/DEEDS PROCESSED
LORAIN COUNTY TAX MAP DEPARTMENT
226 MIDDLE AVE. ELYRIA, OHIO

SURVEYED BY: DOUGLAS H. MOSLEY
CLOSURE: 0.00 : 10.000
MAP PAGE(S): 04-00-017C
APPROVED BY: RFB DATE: 06/10/97
SCALE: 1" = 100'