


#22204

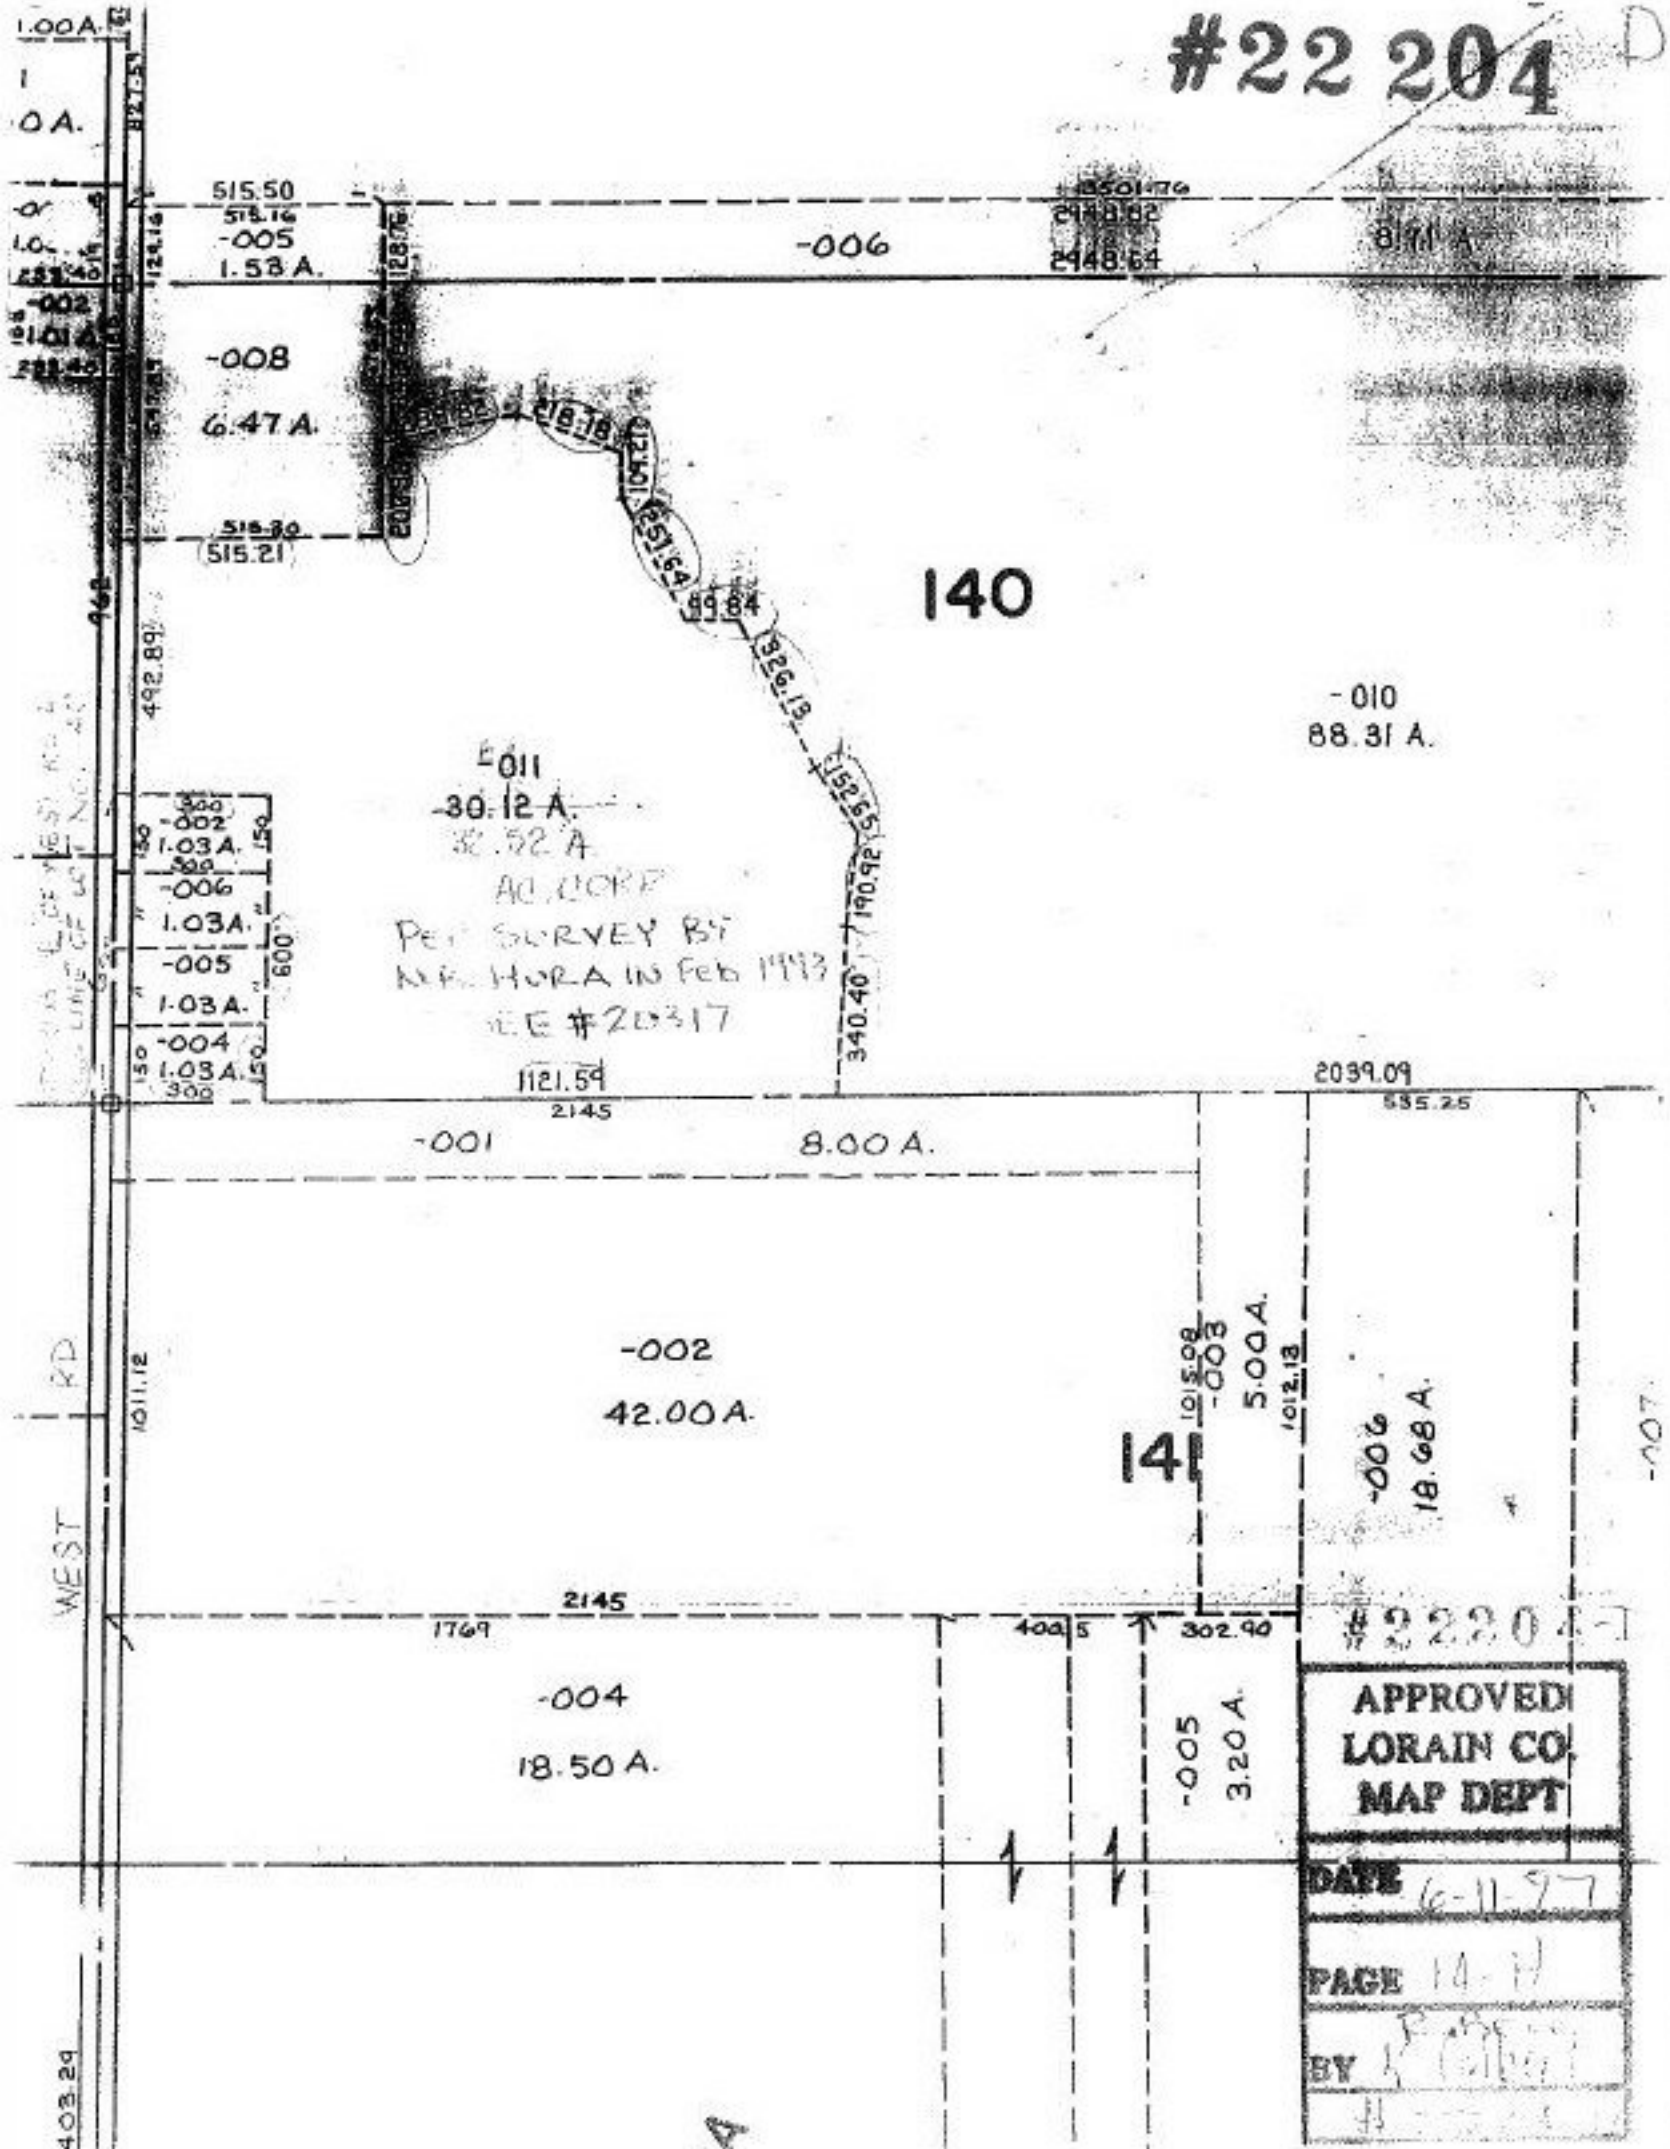

E 011  
 30.12 A.  
 32.52 A.  
 AC. CORP.  
 PER SURVEY BY  
 MR. HURA IN FEB 1913  
 SEE #20317  
 1121.59

-001 2145 8.00 A.

-002 42.00 A.

-004 18.50 A.

141

-005 3.20 A.

-006 18.68 A.

APPROVED  
LORAIN CO.  
MAP DEPT

DATE 6-11-97

PAGE 10-11

BY

A