


#22204
NO. 22204

PARENT PARCEL: 07-00-032-000-035 & 042
CHILD PARCEL: 07-00-032-000-049 THRU 051 & 07-00-029-000-100
STARTING POINT: INT CL STONEY RIDGE RD & CL BARRES RD

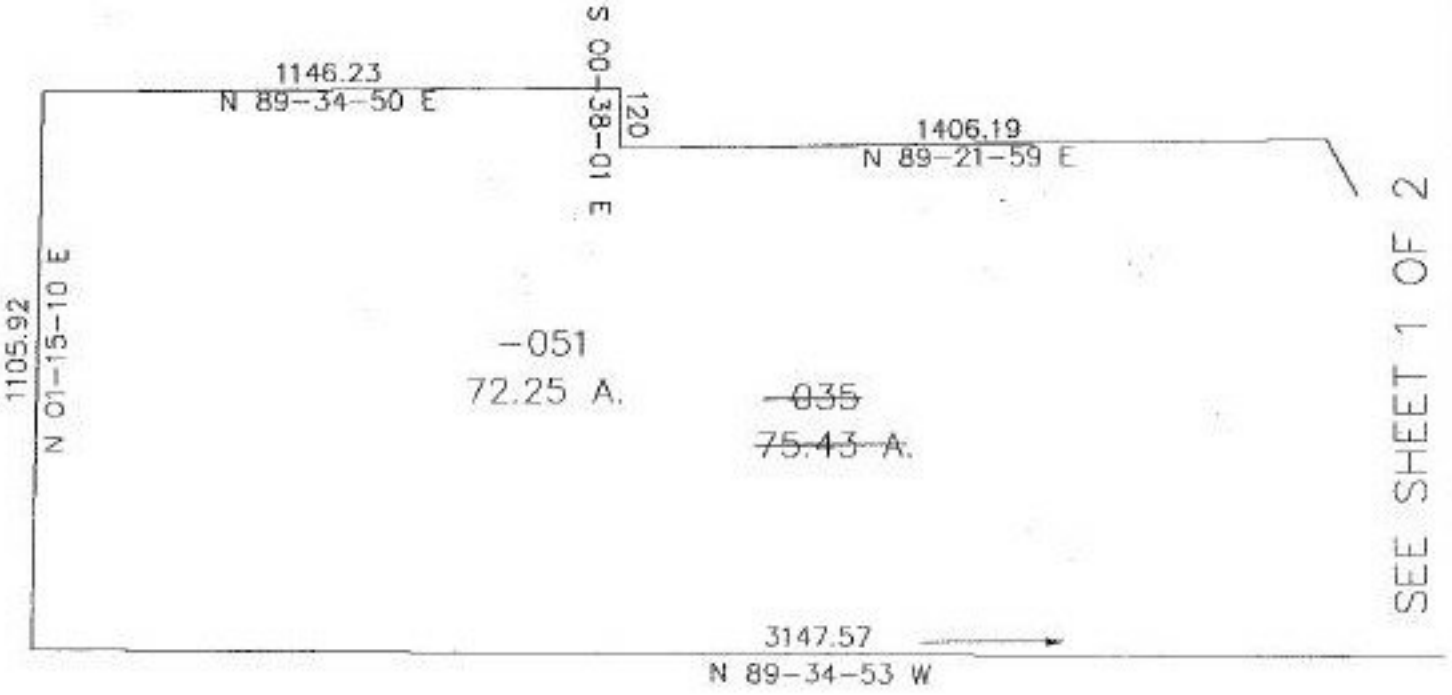

SPLITS/DEEDS PROCESSED
LORAIN COUNTY TAX MAP DEPARTMENT
226 MIDDLE AVE. ELYRIA, OHIO

SURVEYED BY: DANE A. HAPONEK
CLOSURE: 0.05 : 10,000
MAP PAGE(S): 7-B & 07-00-029 C
APPROVED BY: REB DATE: 06/25/97
SCALE: 1" = 400'