


#22205-D

C GRIGGS

RD. 60

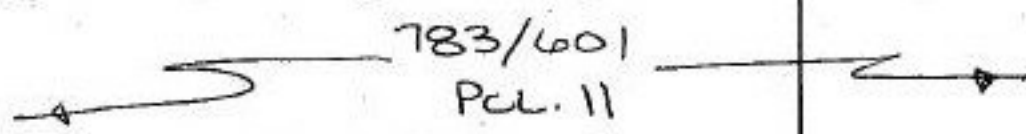

Pt -026
Pt. 53.89A

-002
2.00A.

Line.

Pct. 11

- (-026) 53.89 A - O.L. 17
- (-008) 5.00 A > O.L. 18
- (-009) 4.00 A
- (-002) 2.00 A - O.L. 17
- (-010) 1.34 A - O.L. 16

66.23 A total & Deed ✓

-004
11.90A.

**NO CHANGES
OF TAX MAP**

#22205-D

-005
3.60A.

APPRO LORAIN MAP DE	D J. T
DATE 6-25-97	SEP 20
20-05-017B	
PAGE	
BY R. Bell	
# 22205-D	

UPDATE LEGAL