


#22 205

Pt. -026  
Pt. 53.89 A

PCL II  
783/601

SEE 20-05-017-E

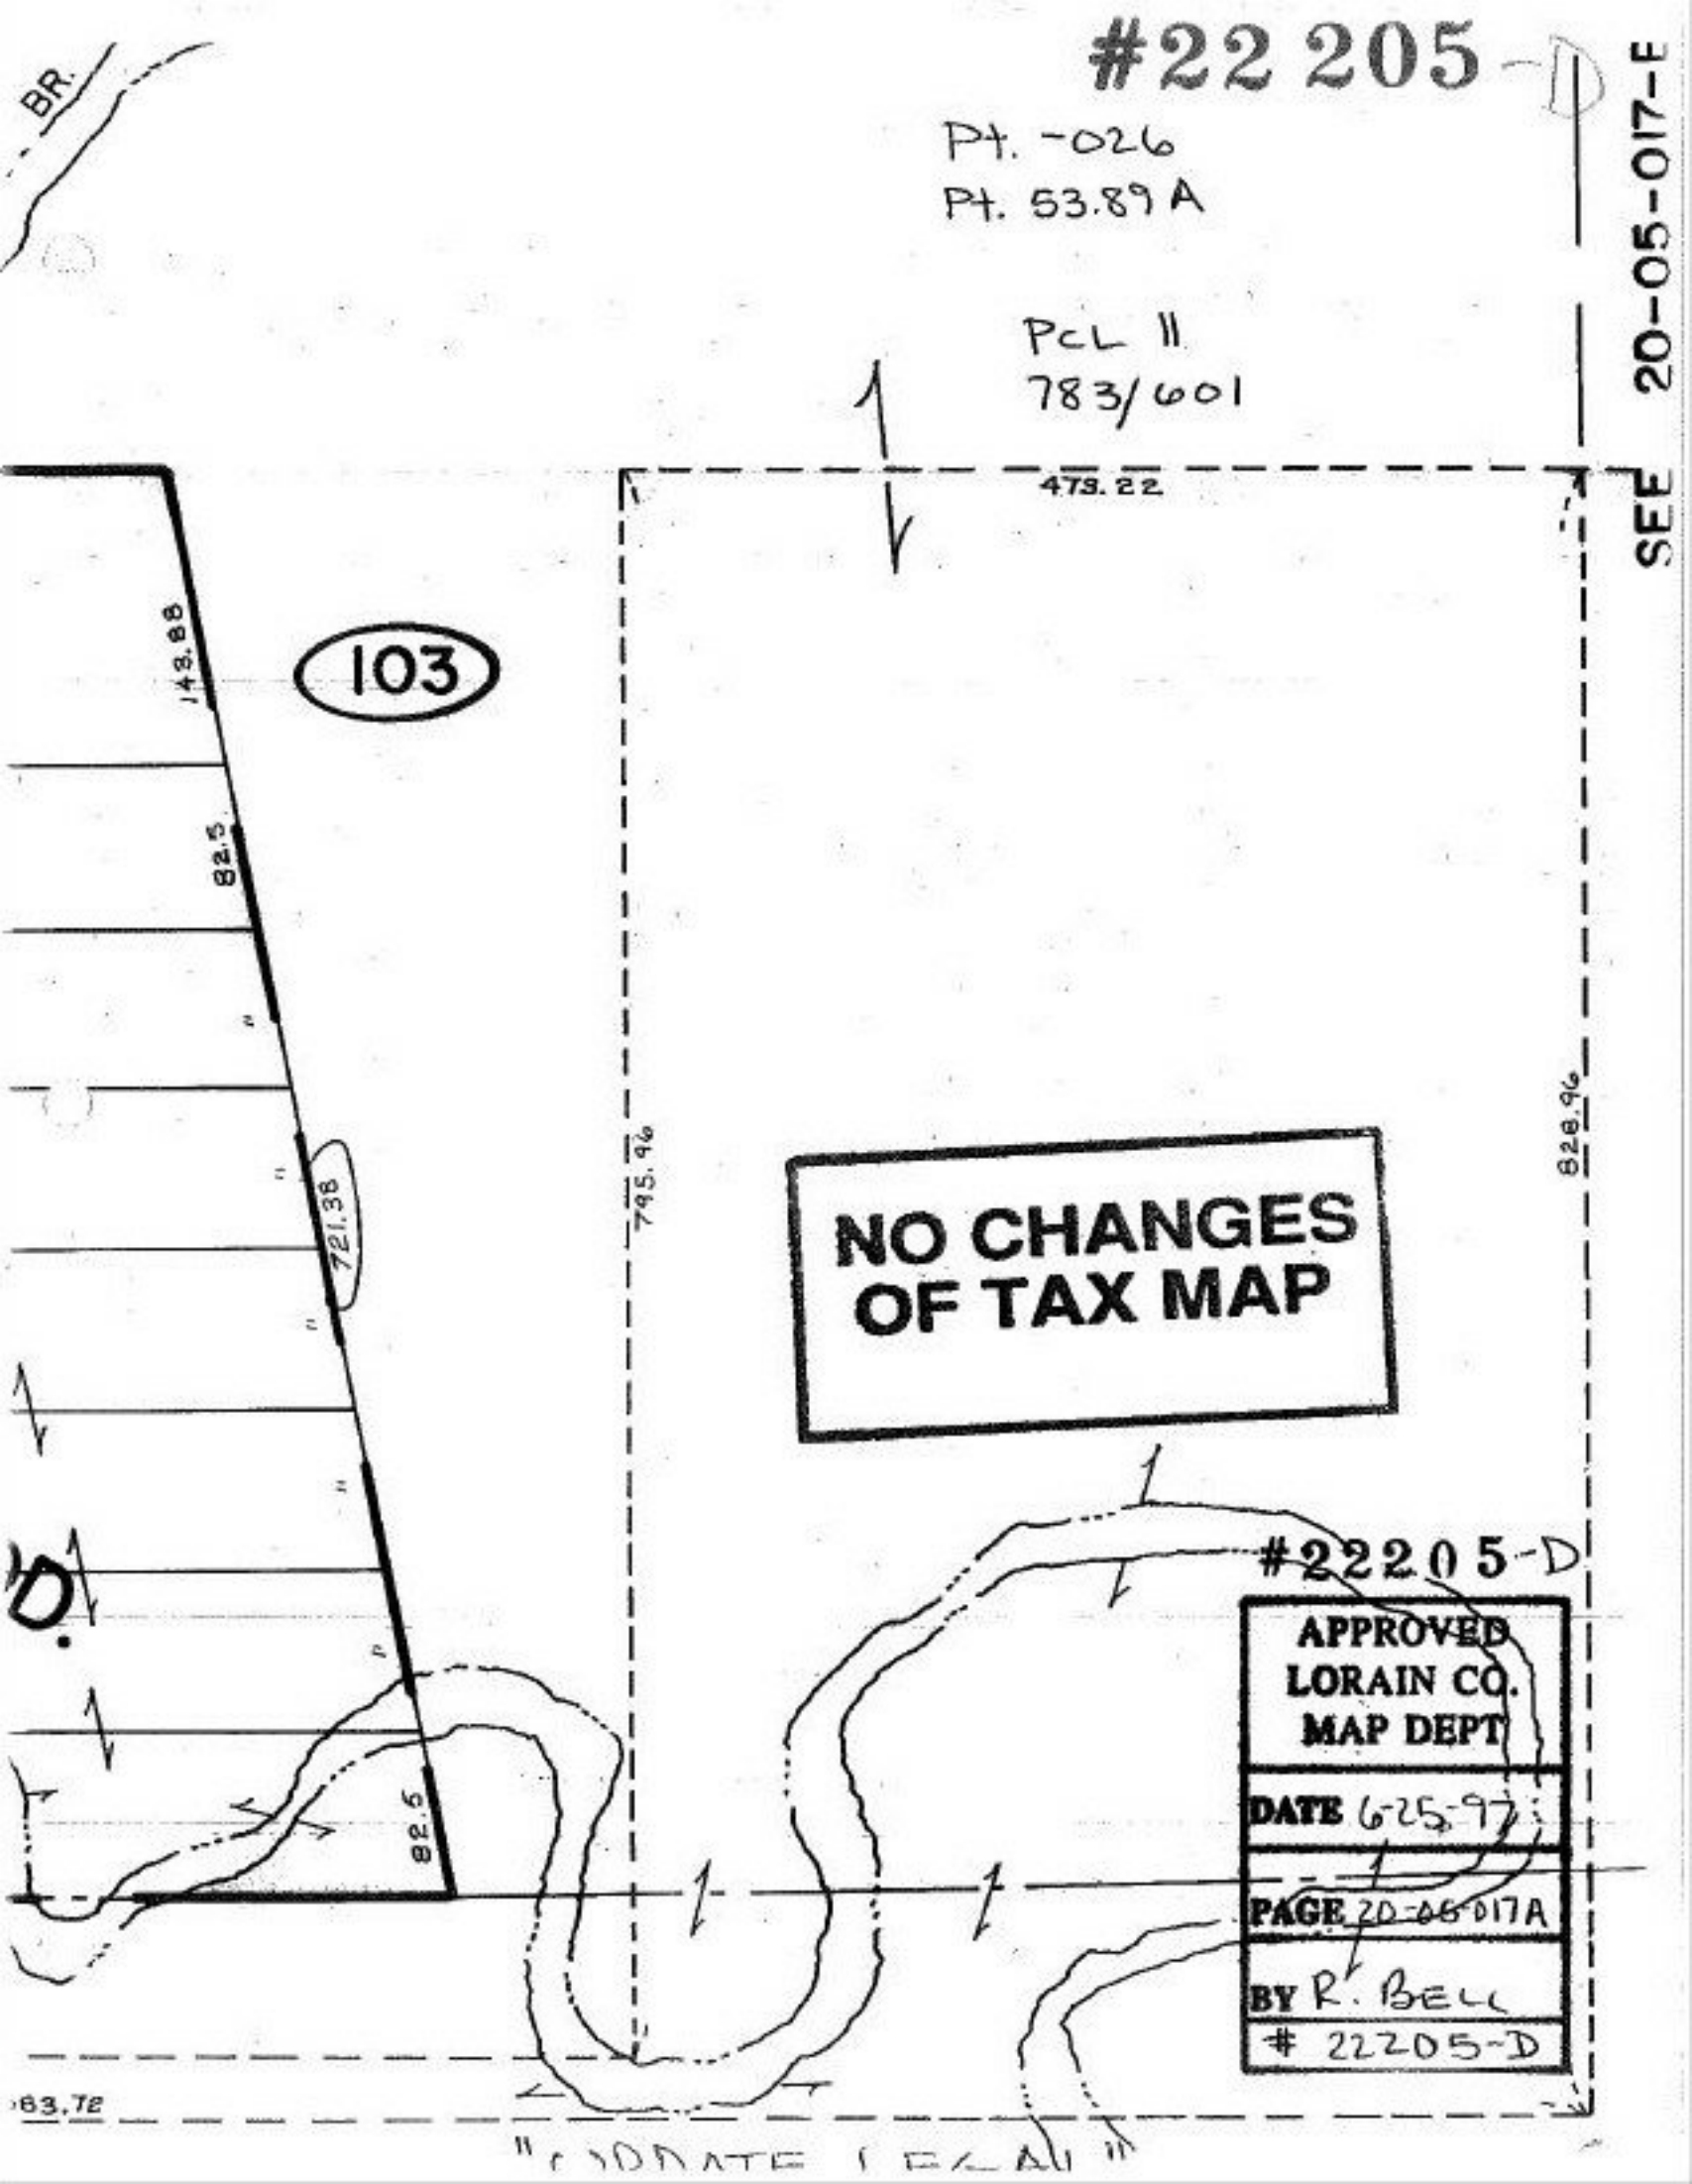

103

**NO CHANGES  
OF TAX MAP**

#22205-D

APPROVED LORAIN CO. MAP DEPT
DATE 6-25-97
PAGE 20-05-017A
BY R. BELL
# 22205-D

"NO DATE (EAL)"