


#22212

NO. 22212

PARENT PARCEL: 01-00-067-000-011
CHILD PARCEL: 01-00-067-000-013
STARTING POINT: INT NORTH LINE O.L. 67 & CL BANK STREET

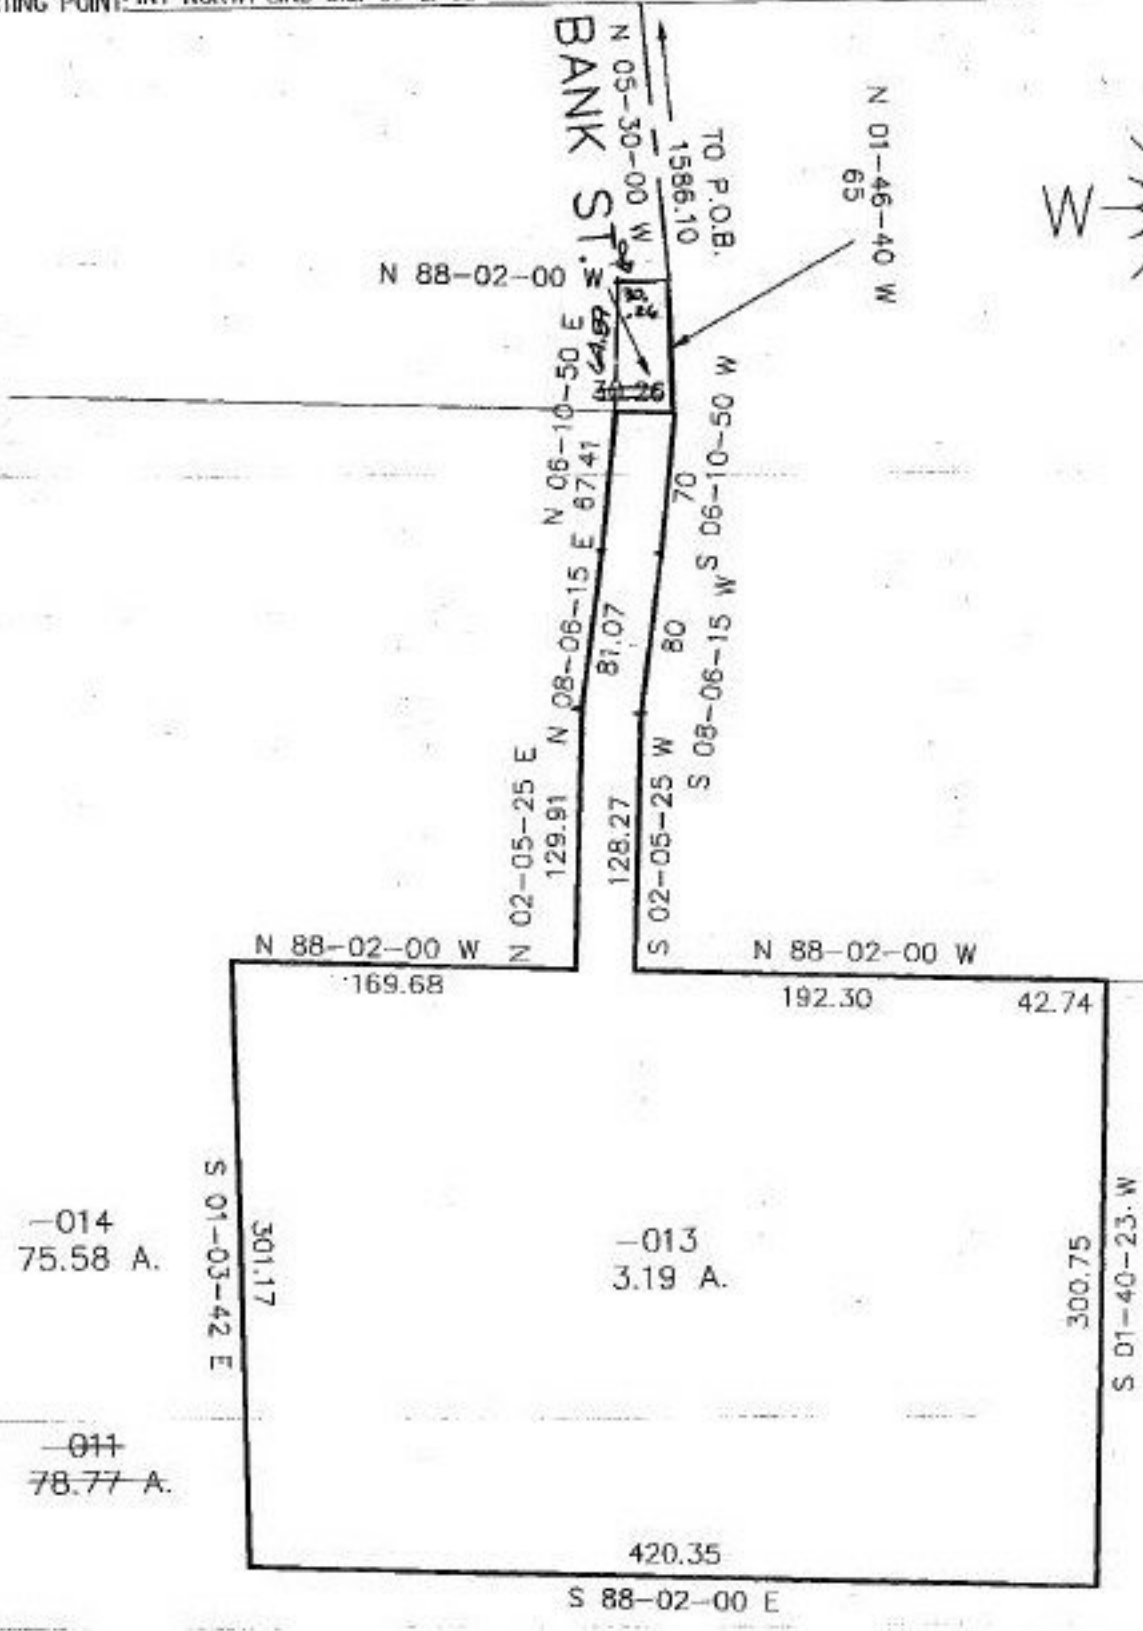

SPLITS/DEEDS PROCESSED
LORAIN COUNTY TAX MAP DEPARTMENT
226 MIDDLE AVE. ELYRIA, OHIO

SURVEYED BY: PATRICK A. MCGANNON
CLOSURE: 0.01 : 10,000
MAP PAGE(S): 1-1
APPROVED BY: RFB DATE: 06/23/97
SCALE: 1" = 100'