

#22213

NO. 22213

PARENT PARCEL: 01-00-013-000-049

CHILD PARCEL: 01-00-013-000-050, 051 & 052


STARTING POINT: cL of Brownhelm Station Rd. & cL of Sunnyside Rd.



SUNNYSIDE ROAD

BROWNHELM STATION ROAD

P.O.B.  
SPIKE FD

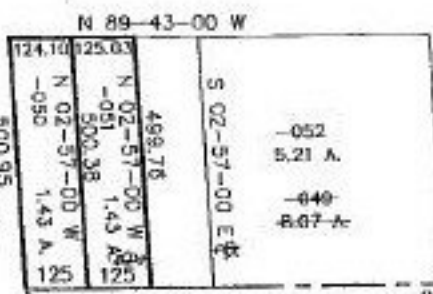

S 02-50-37 E  
500.95

2720.08 S 90-00-00 E



**SPLITS/DEEDS PROCESSED**  
LORAIN COUNTY TAX MAP DEPARTMENT  
226 MIDDLE AVE. ELYRIA, OHIO

SURVEYED BY: Daniel E. Hartung Jr.  
CLOSURE: 0.03 per 10,000  
MAP PAGE(S): 1-B  
APPROVED BY: kac/RFH DATE: 06/26/97  
SCALE: 1" = 400'